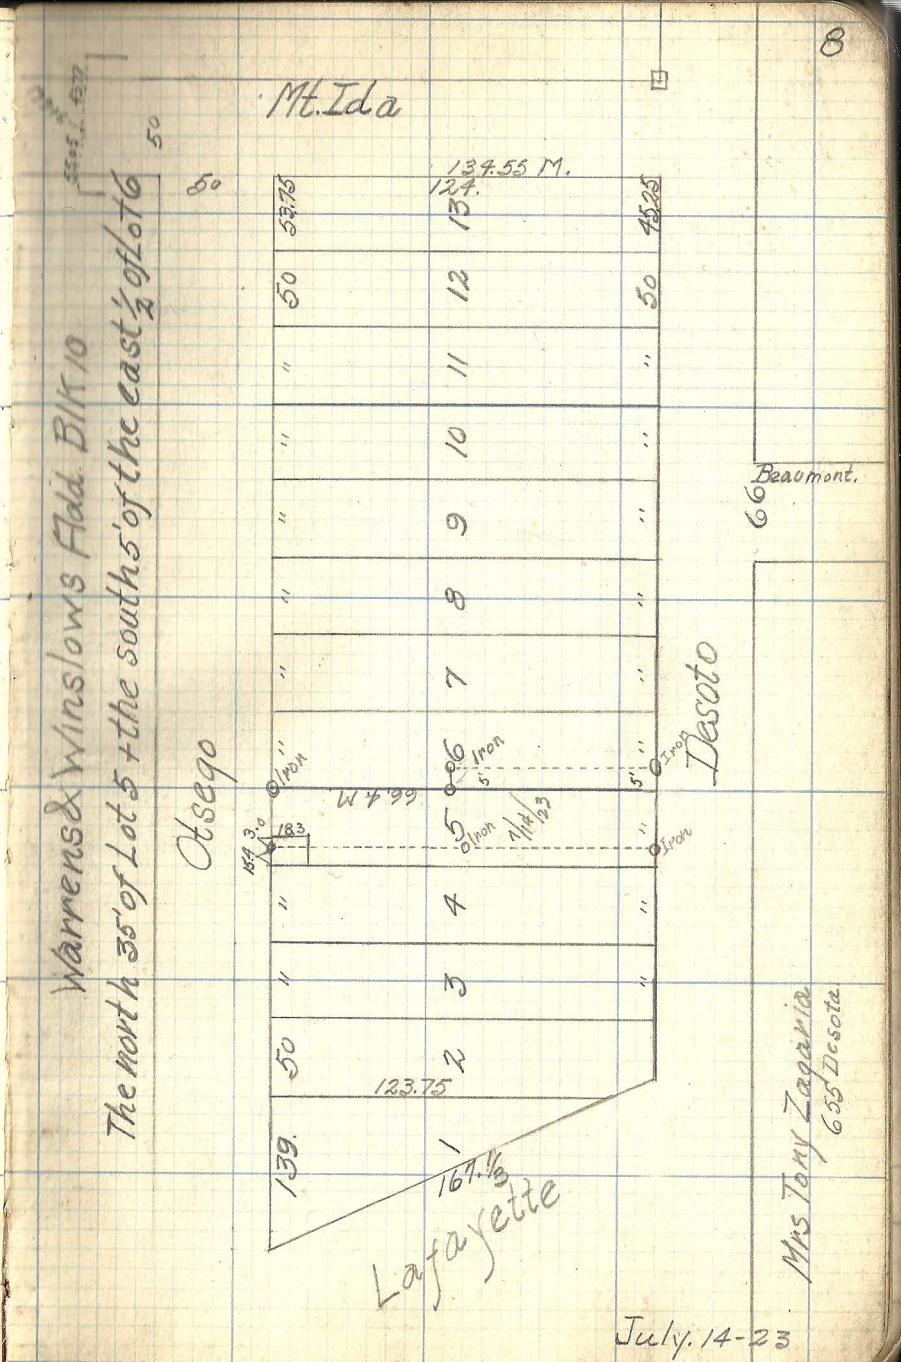
Mt. Ida
134.55 M.
124.
53.75
45.25
50
50
50
50
13
12
11
10
9
8
7
6
5
4
3
2
1
139.
123.75
167.1/3
Otsego
Desoto
Lafayette
Beaumont.
66
Iron
Iron
Iron
Iron
66.4 M
Mrs Tony Zagaria
655 Desota
Warrens & Winslows Add. Blk 10
The north 35' of Lot 5 + the south 5' of the east 1/2 of Lot 6
July. 14-23