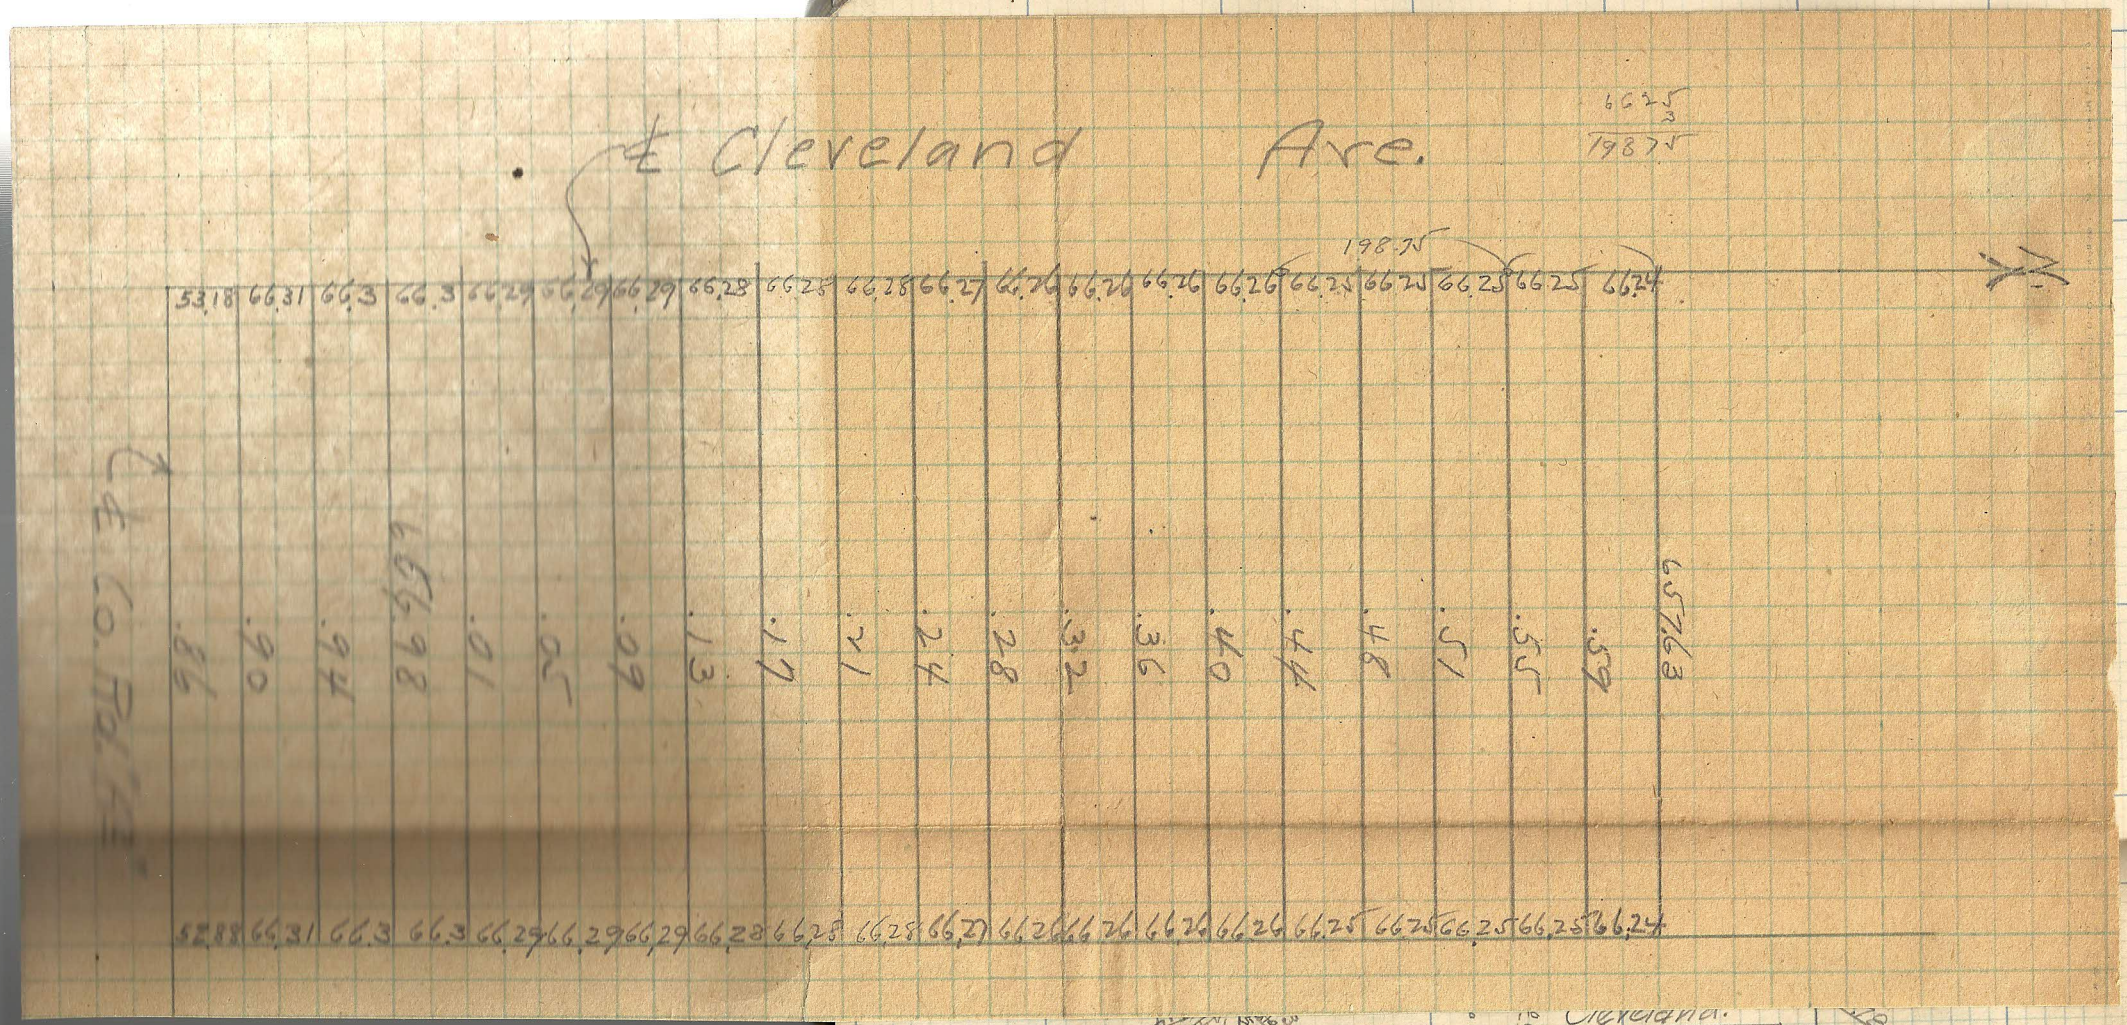

℄ Cleveland Ave.
6625
3
19875
198.75
53.18 66.31 66.3 66.3 66.29 66.29 66.29 66.28 66.28 66.28 66.27 66.26 66.26 66.26 66.26 66.25 66.25 66.25 66.25 66.24
.86 .90 .94 656.98 .01 .05 .09 .13 .17 .21 .24 .28 .32 .36 .40 .44 .48 .51 .55 .59 657.63
52.88 66.31 66.3 66.3 66.29 66.29 66.29 66.28 66.28 66.28 66.27 66.26 66.26 66.26 66.26 66.25 66.25 66.25 66.25 66.24
℄ Co. Rd. "A"

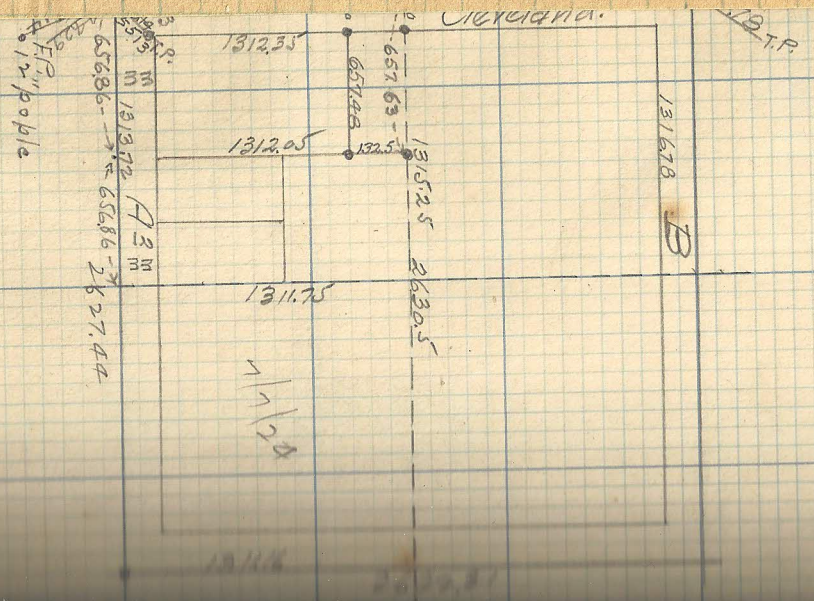

Cleveland.
1312.35
1312.05
1311.75
1315.25
1316.78
A
B