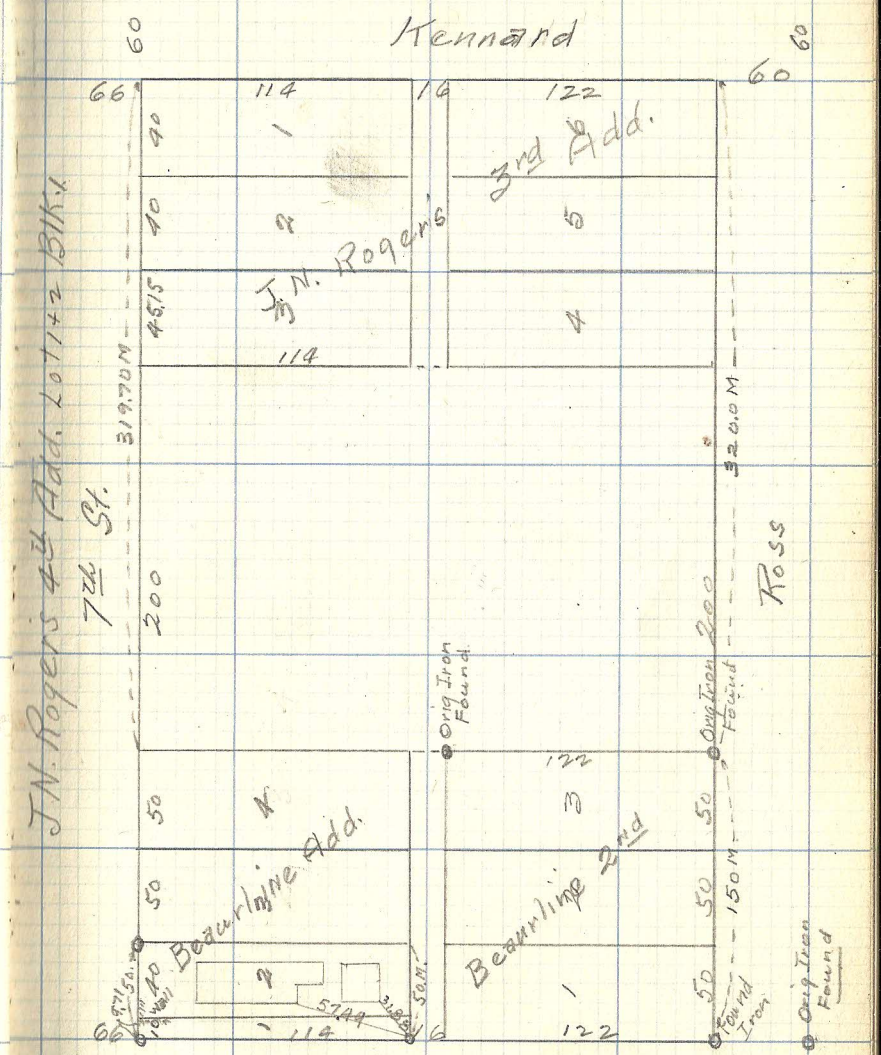
Kennard
60
66
114
122
40
10
9
8
1
2
3rd Add.
5
4
J.N. Rogers'
46.15
114
319.70M
200
7th St.
J.N. Rogers 4th Add. Lot 1 & 2 Blk 1
Orig Iron Found
Orig Iron Found
Ross
122
50
N
3
Beaurline Add.
Beaurline 2nd
50
50
150M
Found Iron
Orig Iron Found
57.44
114
122
60