Lot 29-30 Blk 2
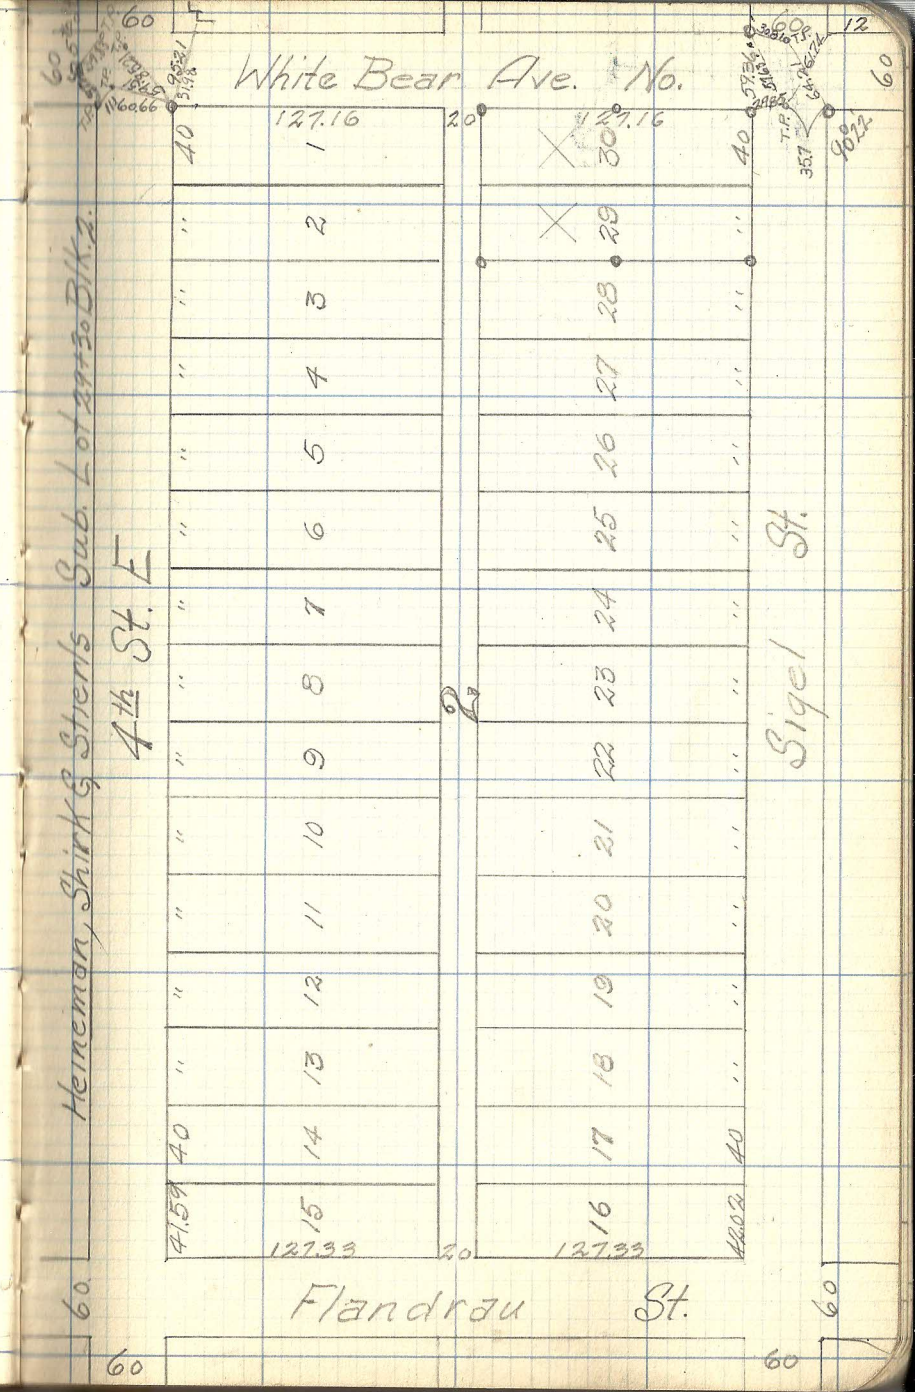
Heineman Shirk & Stiers Sub.