

2635.59

88 10 11

1157

40 40

60


St. Anthony Park North Lot 9-8th. 80

Cleveland Ave. 3200 = R

Buford Ave. 3200 = R

4006

80

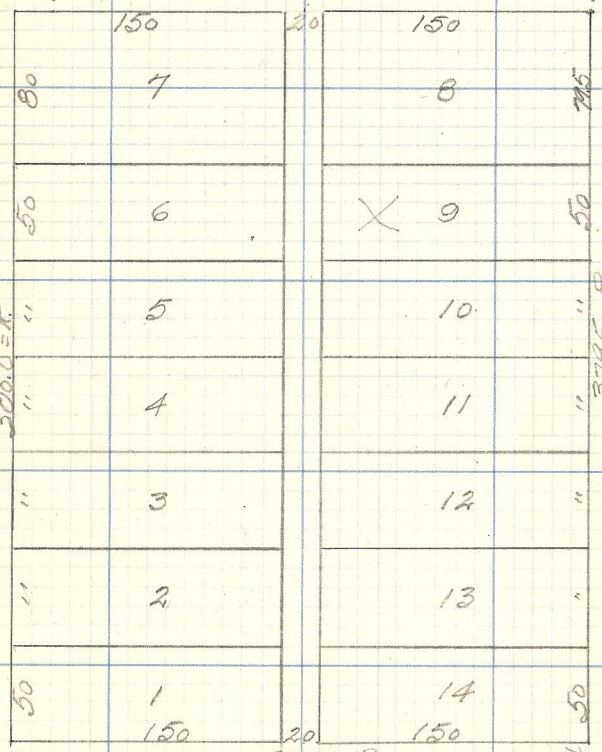

66

211982

33

Hendon Ave.

32 3294

66

66