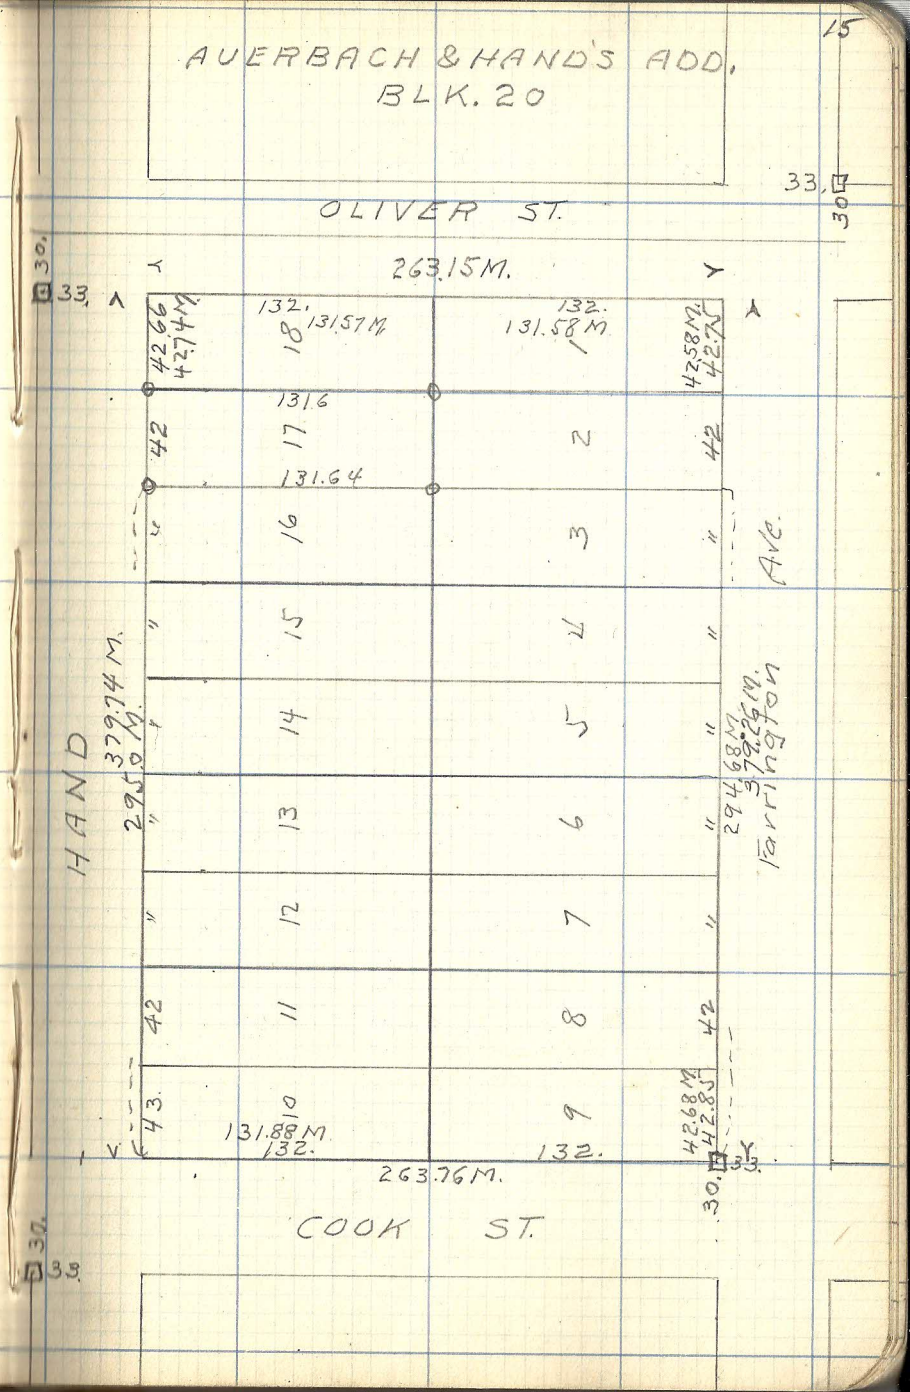
AUERBACH & HAND'S ADD.
BLK. 20
OLIVER ST.
263.15M.
132.
131.57M.
131.58M.
42.66
42.74M.
42.58M.
42.7
131.6
131.64
18
17
16
15
14
13
12
11
10
1
2
3
4
5
6
7
8
9
42
379.74M.
HAND
131.88M.
132.
263.76M.
42.68M.
42.8
COOK ST.
AVE.
30.
33.