


CHARLES ST.

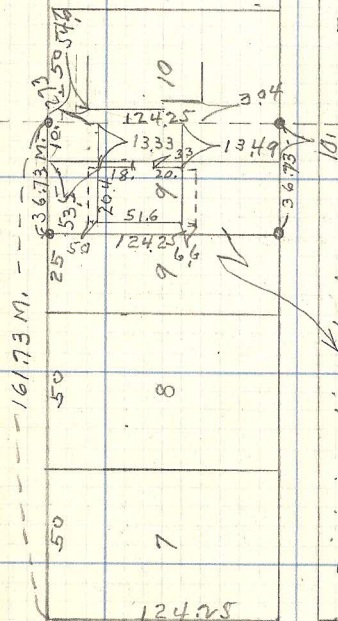

Dividing Line Bet. Warren + Ricds + Robertson + Van Ettens Add. According to Recorded Plats

True Dividing Line Bet. Warren + Ricds + Robertson + Van Ettens Add.

FARRINGTON AVE.

SHERBURNE AVE