

66

Lot 1 BIKI. Wards Sub.


66

19

Albert Ave

60

60

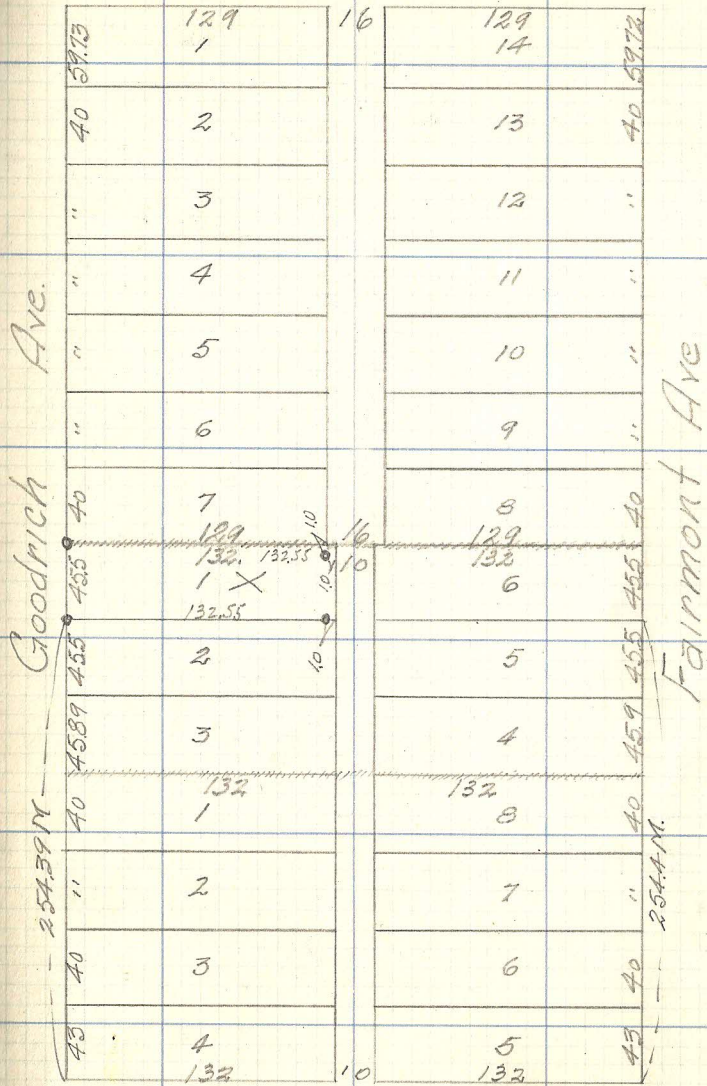

Goodrich Ave.

Fairmont Ave

254.39M

254.4M

60

Pascal Ave.

60

66

66