John Gaarden's Fourth Add.

Feb. 14. 1925
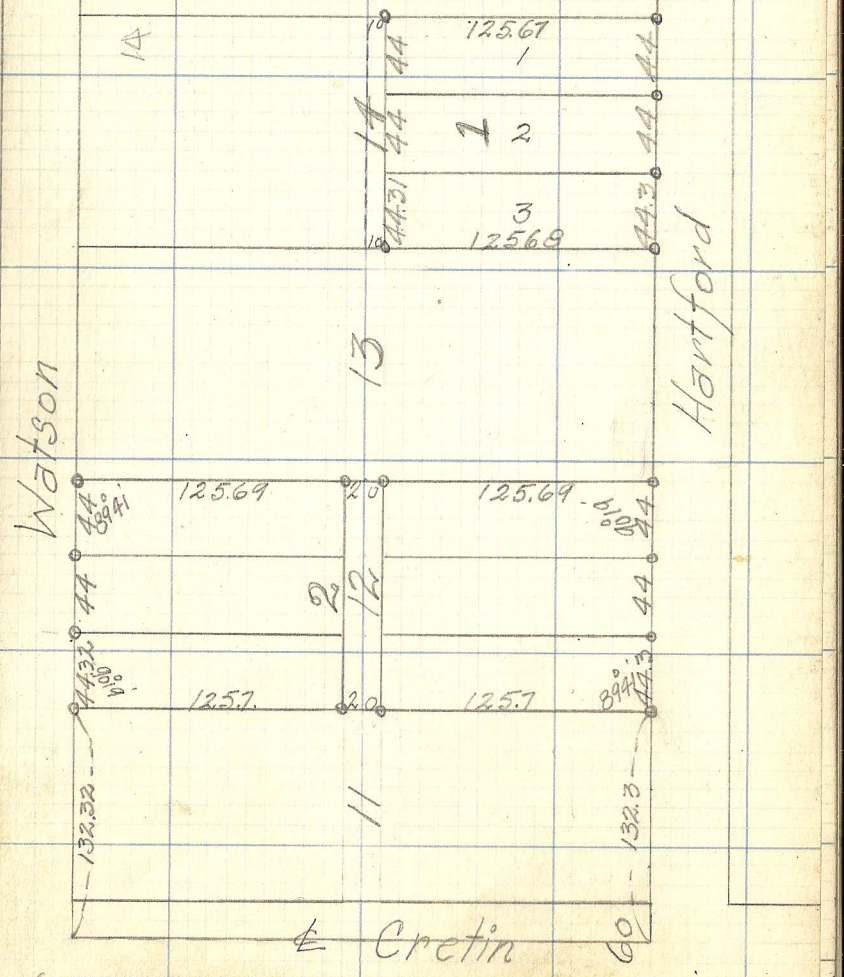
Lot 12 & the So. ½ of Lot 14 in Suburban Acre Lots.