


66 Lot 4. Blk. 3 Homecroft Add. 66 22

66

66

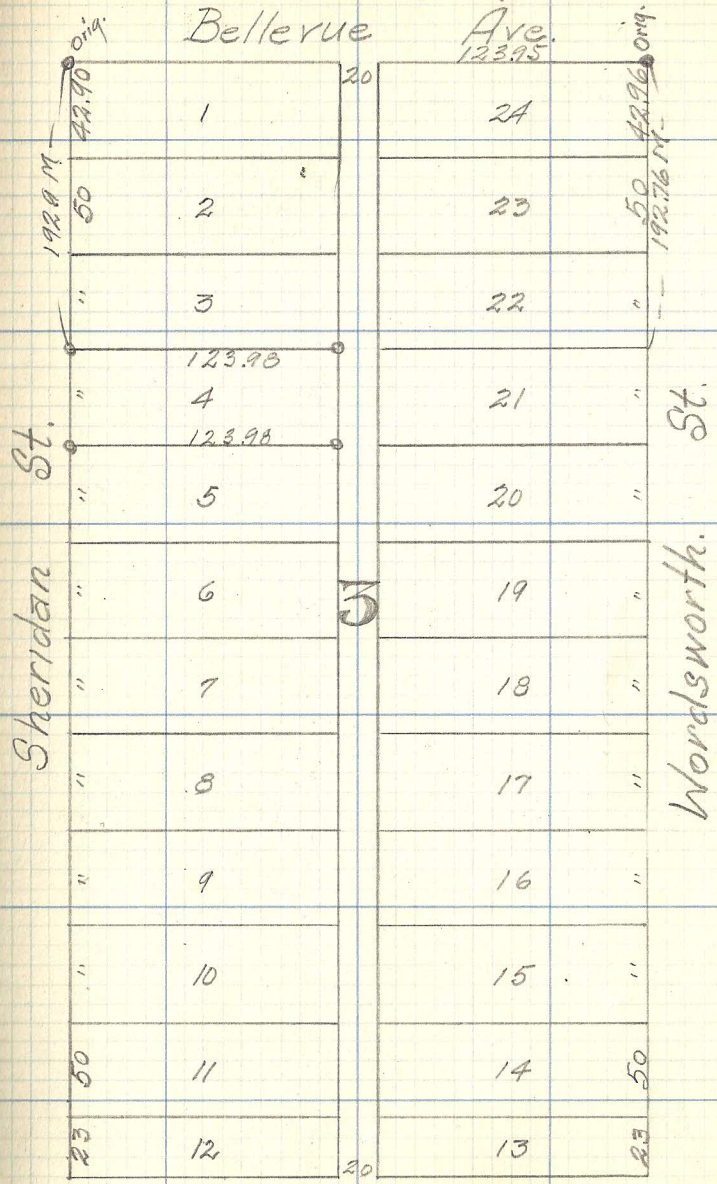

120

120

66

66

Edgcumbe Road.