


Lots 3+4 B/K/I
Loverings Add.

Shields Ave.

268.50R 268.50M 20+05.74
127.25 127.25 127.25

52.25
21.50

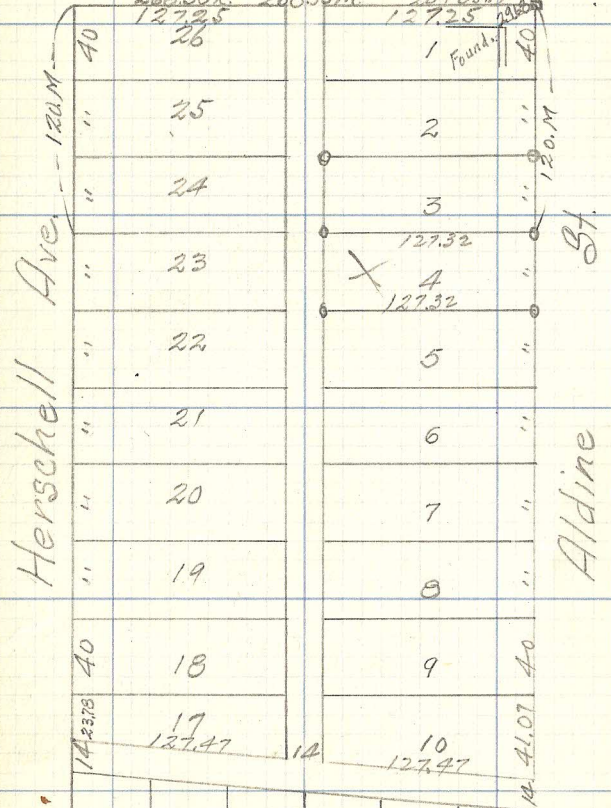

Herschell Ave. -- 120M

Aldine St.

40	26	1 Found.	40
"	25	2	"
"	24	3	"
"	23	127.32	"
"	22	X 4 127.32	"
"	21	5	"
"	20	6	"
"	19	7	"
40	18	8	40
14.2378	17 127.47	9	14.41.07
14		10 127.47	14

130
16
15
14
13
12
11
130

St. Anthony Ave.

45 43.95
14+26.7
T.P.