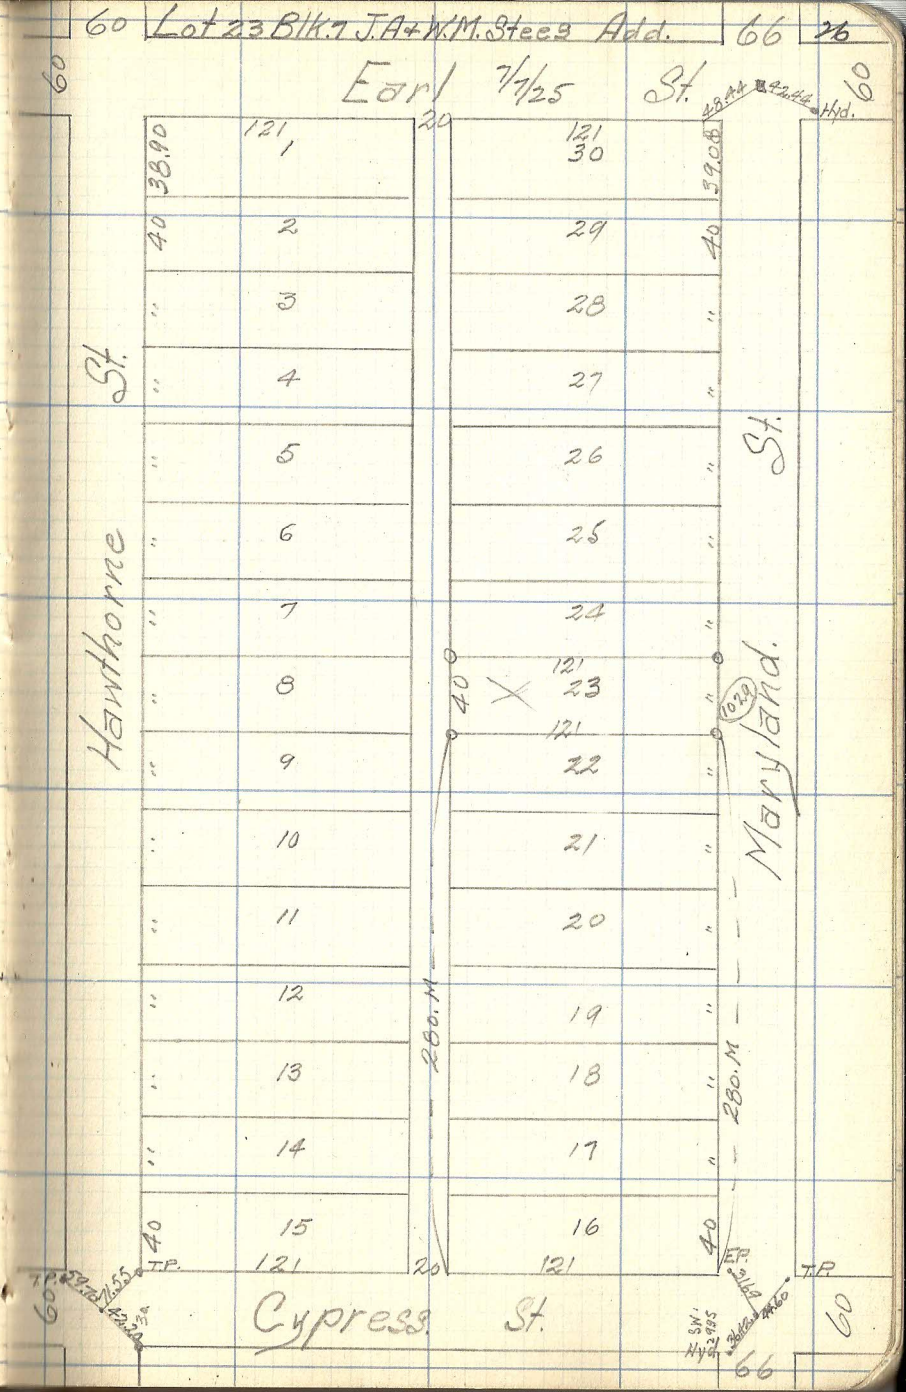Lot 23 Blk. 7 J.A. & W.M. Steed's Add.