


Manomin 300.20 M.

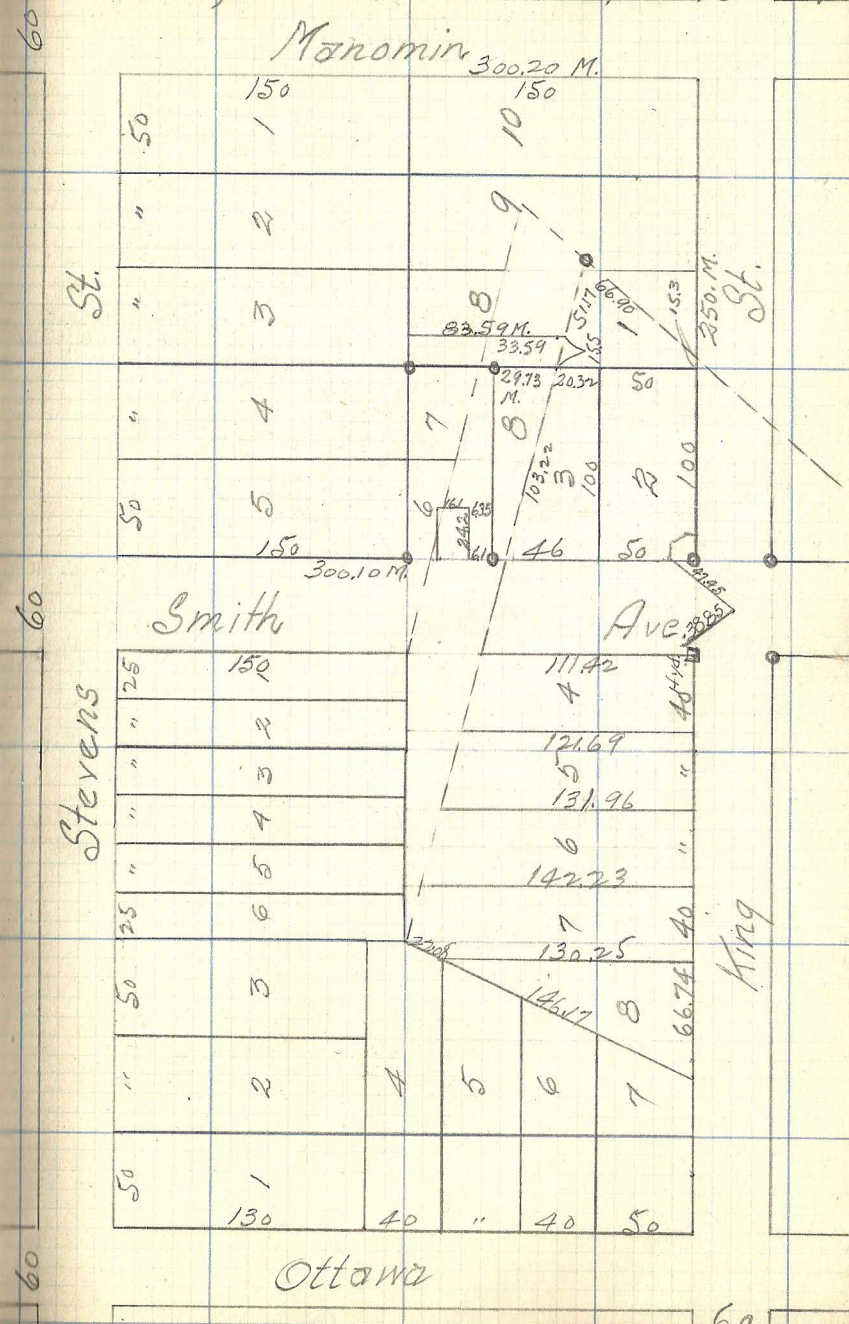

St.

Stevens

Smith

Ave

King

Ottawa

60

60

60

60