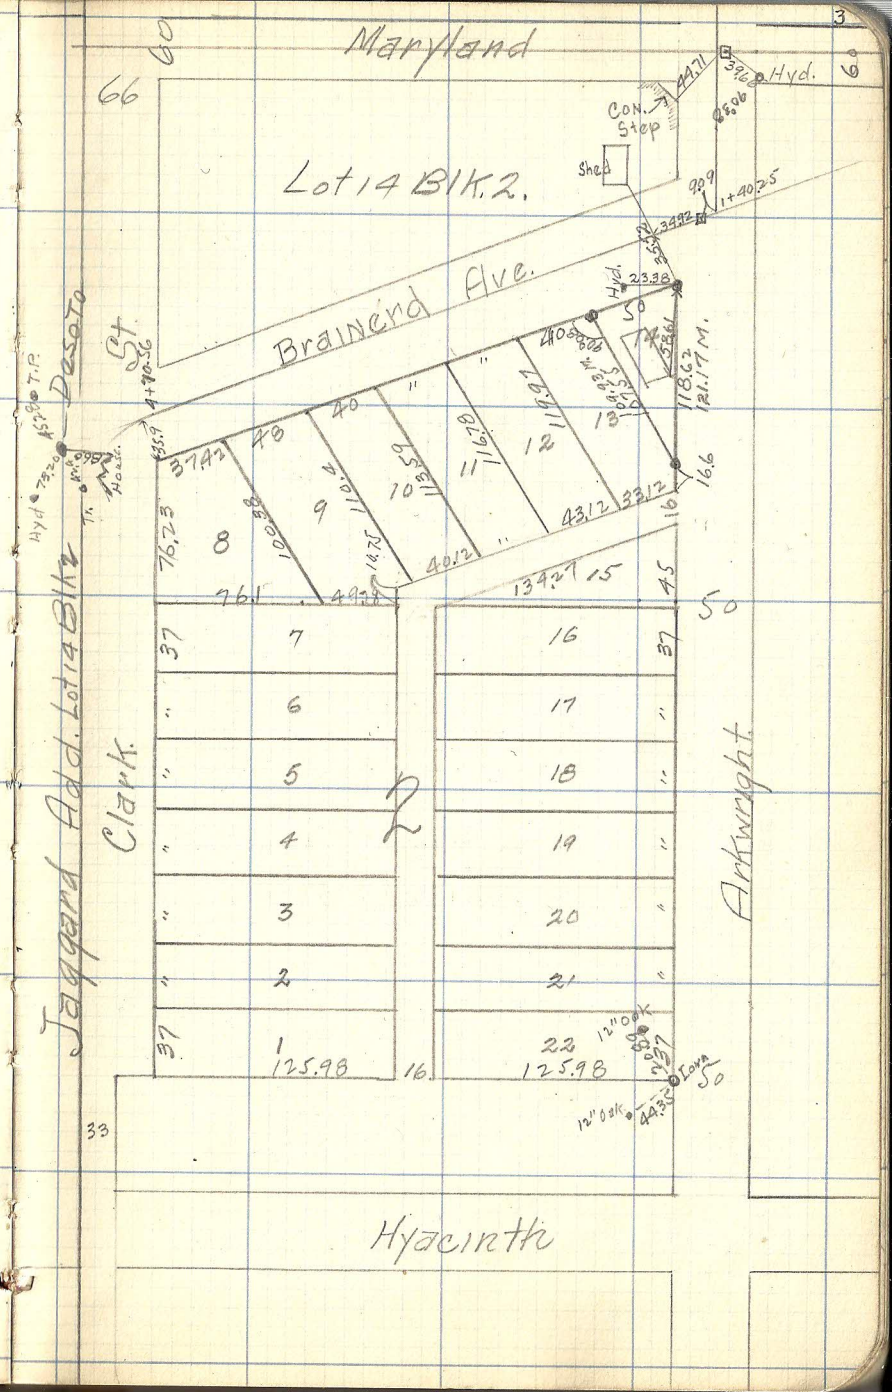
Maryland
Lot 14 Blk. 2.
Brainerd Ave.
Desoto St.
Jaggard Add. Lot 14 Blk 2
Clark
Arkwright
Hyacinth
Hyd.
Con. Step
Shed
Iowa
12" Oak
66
60
50
33
37
125.98
16
7
6
5
4
3
2
1
16
17
18
19
20
21
22
8
9
10
11
12
13
14
15
37.42
76.23
76.1
100.38
110.4
113.59
116.78
119.97
40.12
43.12
33.12
134.27
118.62
121.17 M.
16.6
4+70.56
1+40.25
44.71
39.60
23.38
44.35