


Lot 6+7 BIK. 1  
H.B. Hanson's Add.

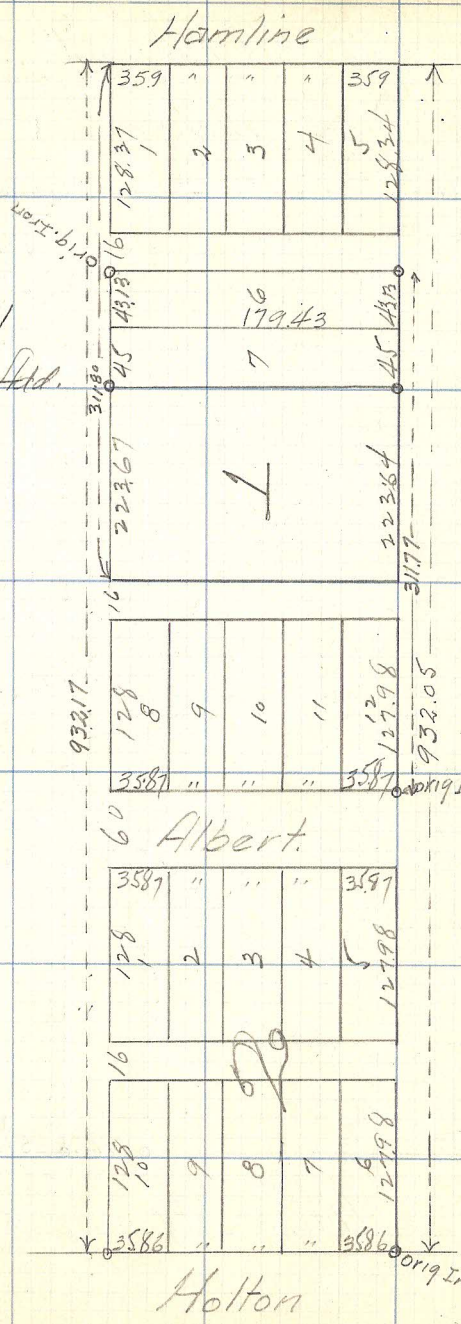

Lot 2 BIK 3  
H.B. Hanson's Add.

