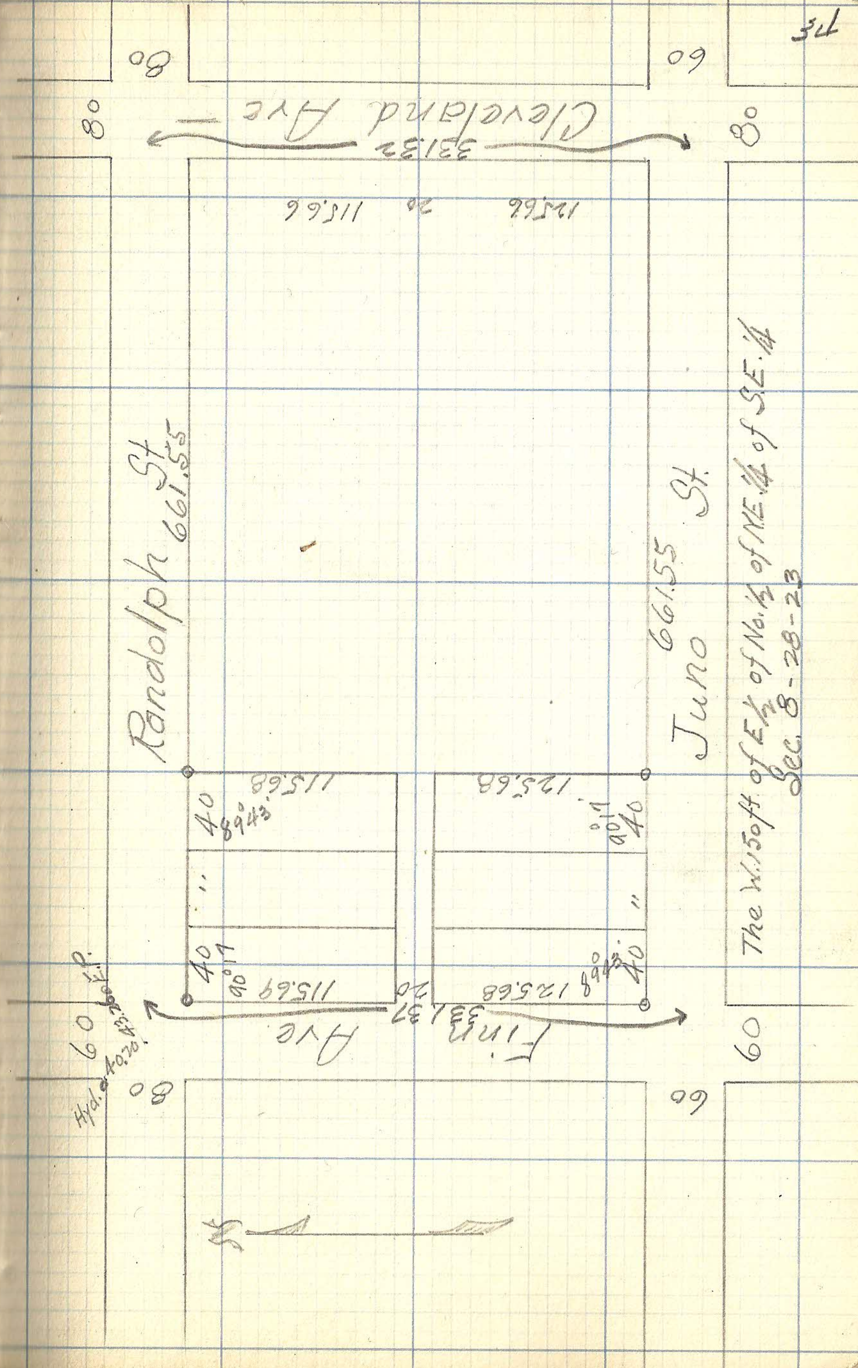

75
Cleveland Ave
331.32
Randolph St
661.55
Juno St
661.55
Finn Ave
331.37
115.68
125.68
115.69
125.68
The W.150ft of E½ of N½ of NE¼ of SE¼
Sec. 8-28-23