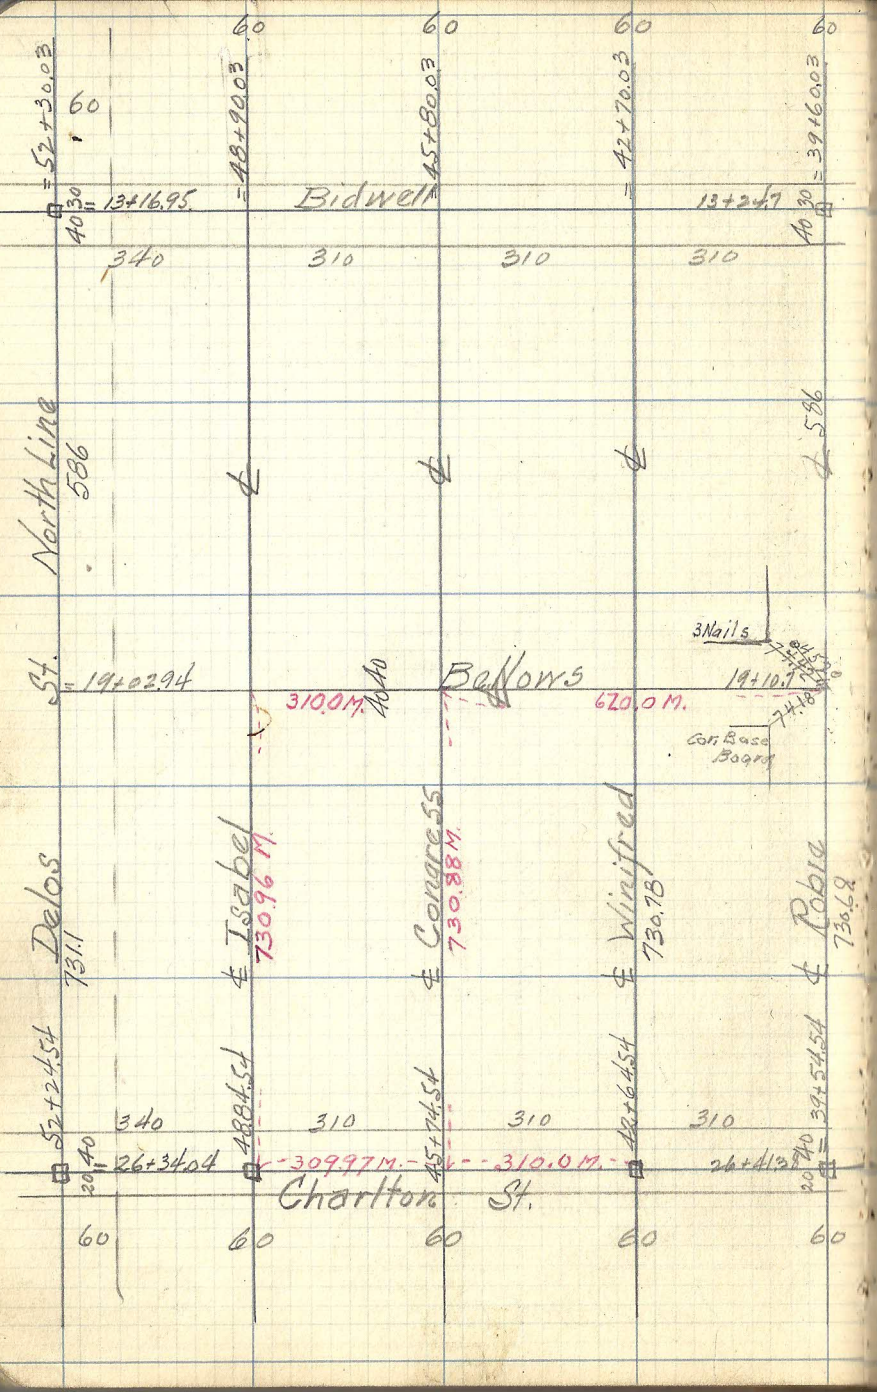
Bidwell
Bellows
Isabel
Congress
Winifred
Robie
Delos
North Line
Charlton St.
3 Nails
Con Base Bagm
310.0 M.
620.0 M.
730.96 M.
730.88 M.
730.78'
730.6
731.1
340
310
586
19+02.94
19+10.1
26+34.04
26+41.30
45+74.54
42+64.54
39+54.54
48+84.54
52+24.54

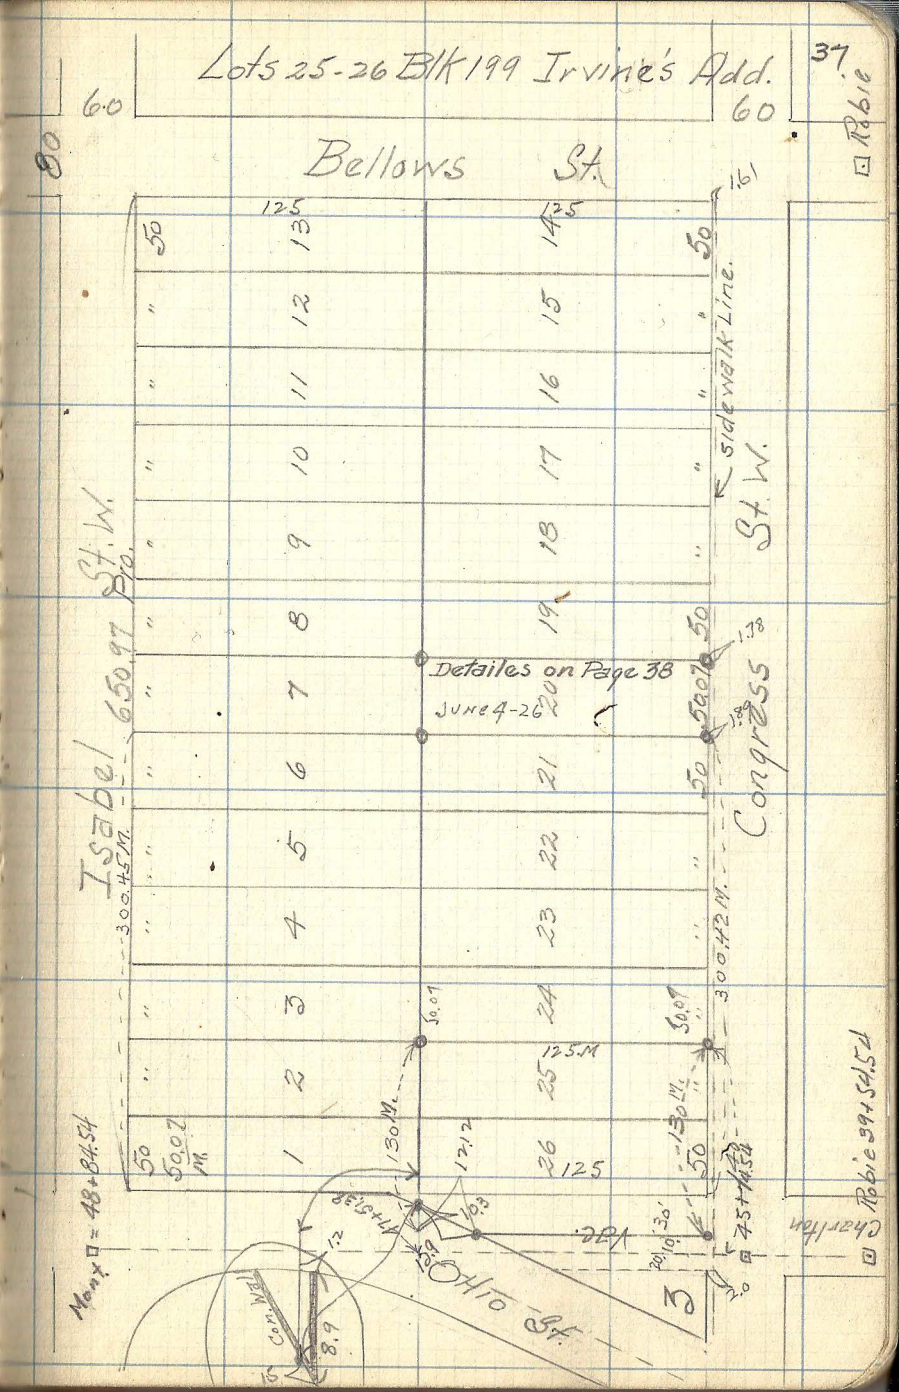
Lots 25-26 Blk 199 Irvine's Add.
37
Bellows St.
St. W.
Isabel
Congress
Ohio St.
Charlton
Robie
sidewalk Line.
Detailes on Page 38
June 4-26
650.97
300.45 M.
300.42 M.
130 M.
123.5 M.
125
50
60
80
161
178
48+84.54
75+74.54
39+54.54