


Nov. 19-26  
20

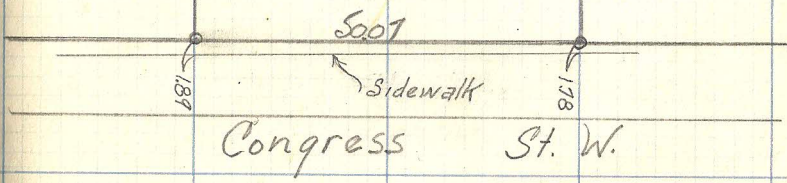

Lot 20 BIK. 199  
Irvin's Add.