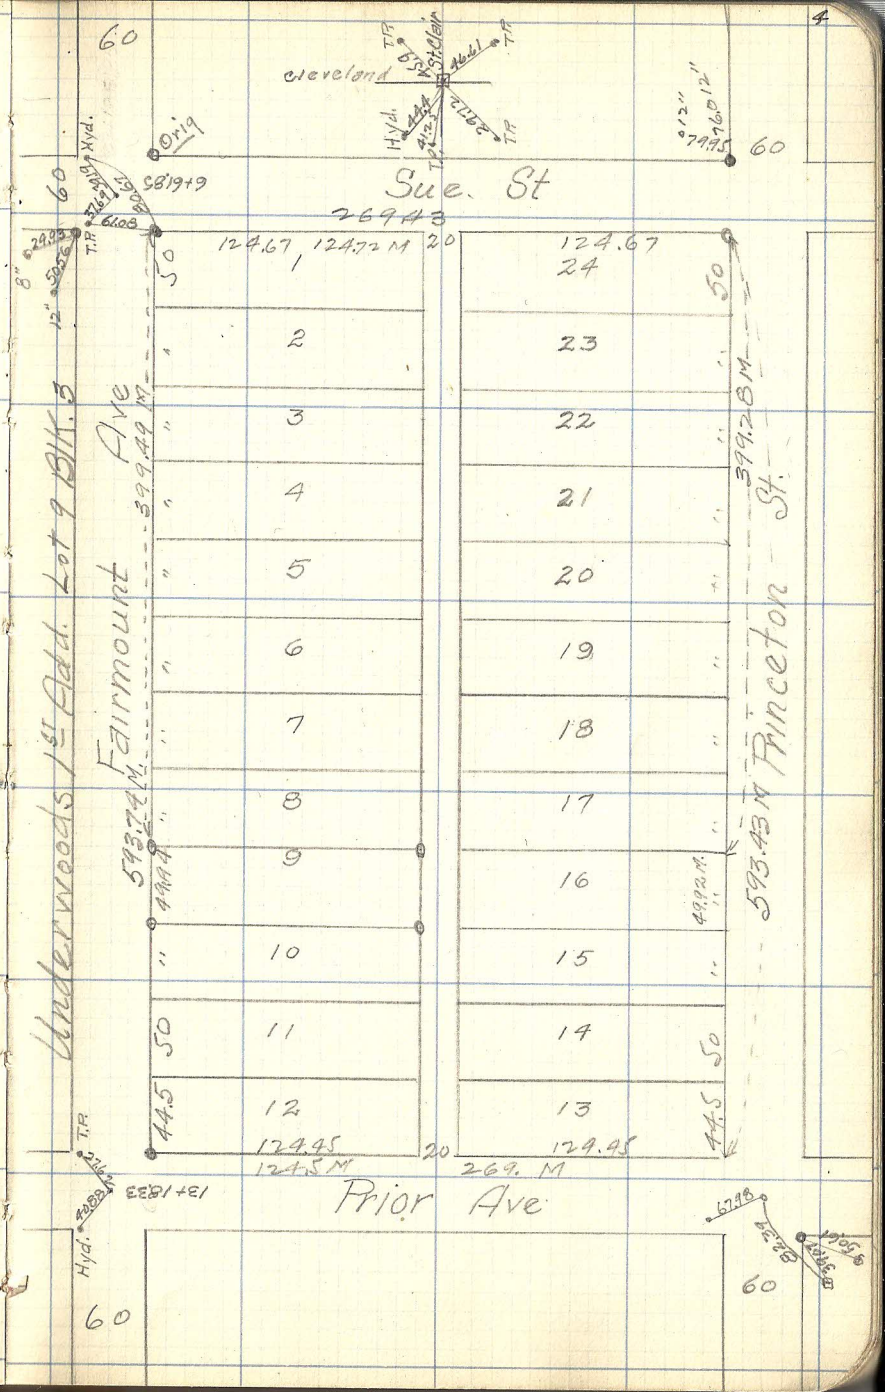
Cleveland
Orig
Sue. St
Fairmount Ave
Princeton St.
Prior Ave
124.67
124.72 M
124.67
124.95
124.5 M
129.95
269. M
399.44 M
399.28 M
593.74 M
593.43 M
Hyd.
T.P.
60
50
44.5