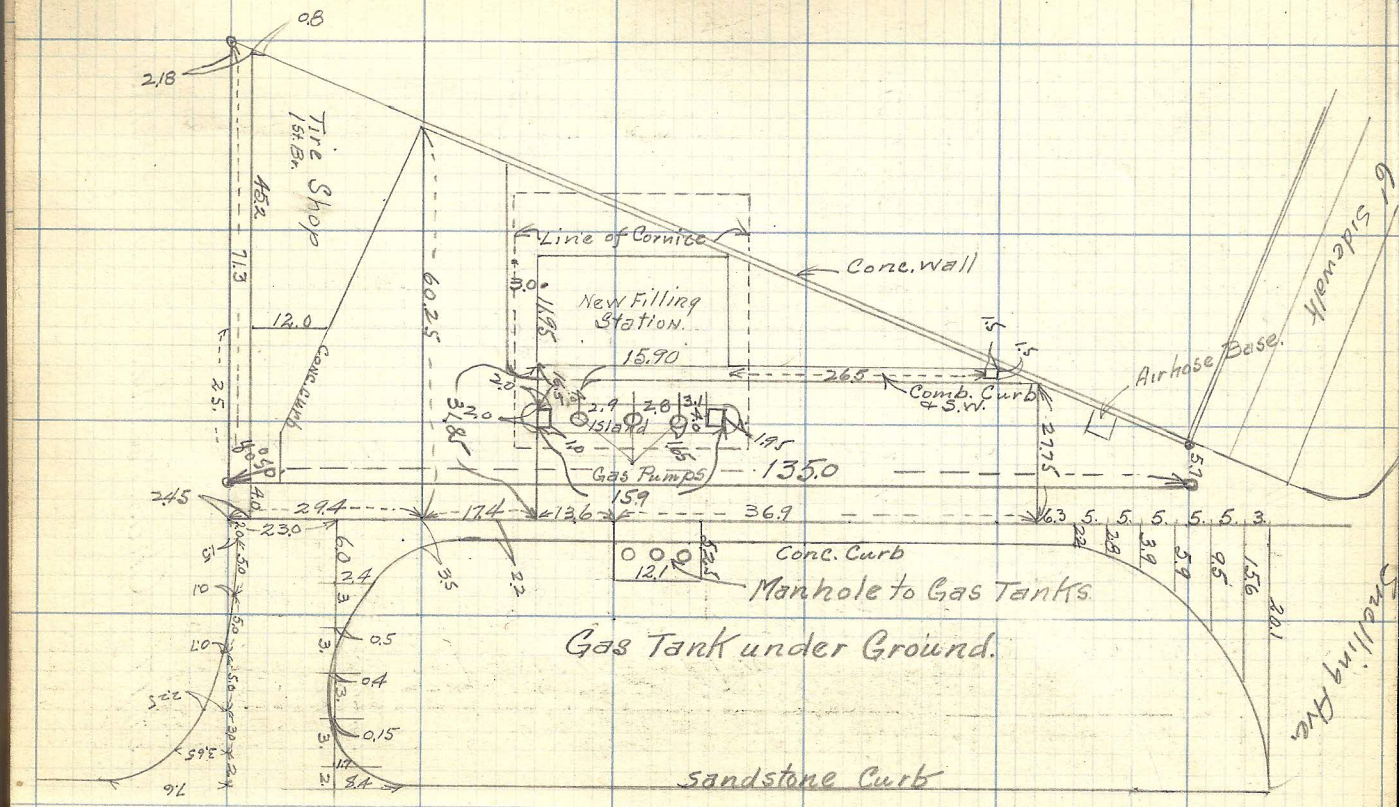

(Pure Oil Co)

Lot 9 Blk. 8 College Park Add.
Aug. 11-26.

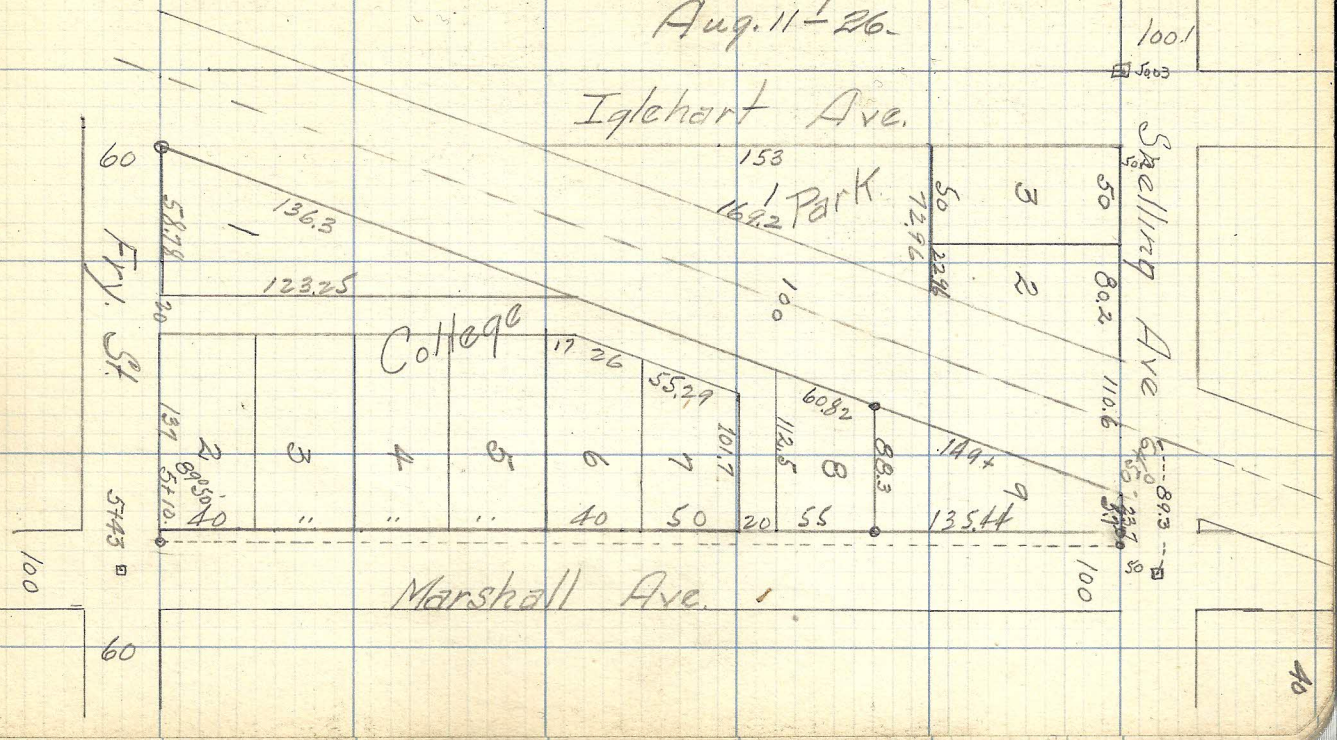

40