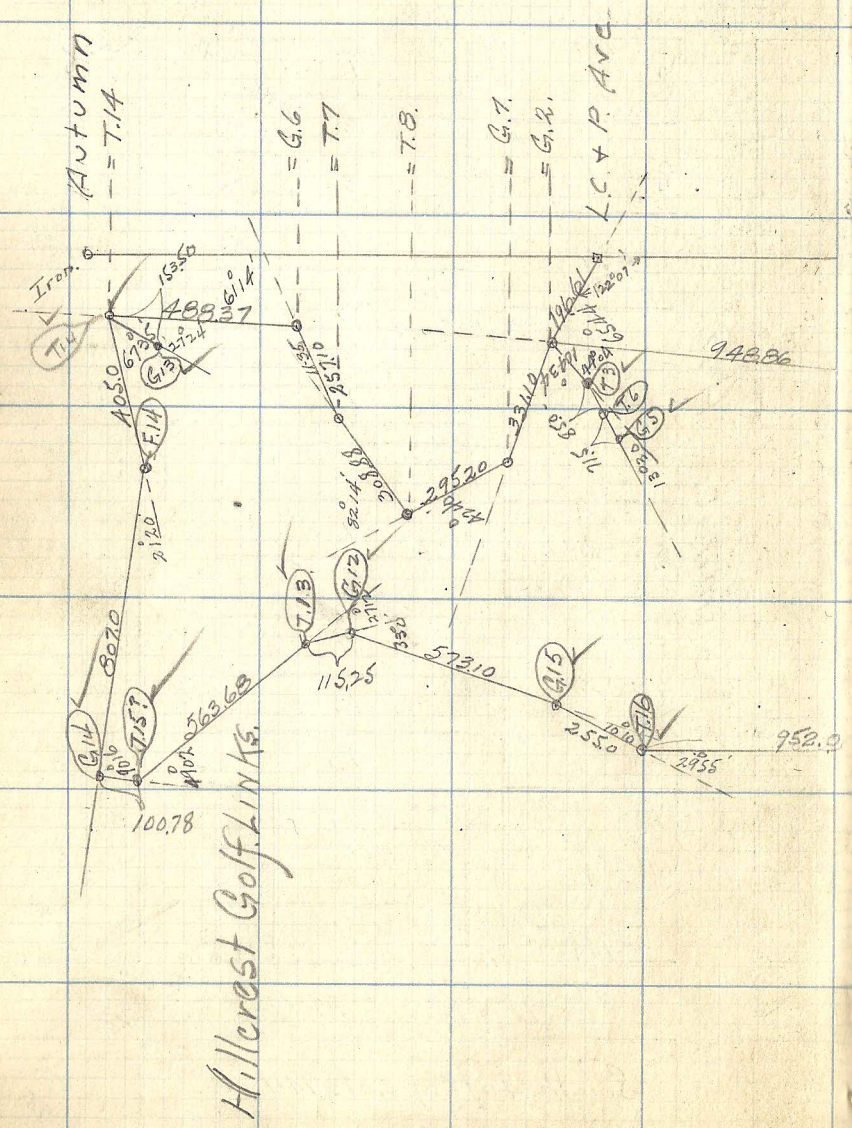
Autumn
= T.14
= G.6
= T.7
= T.8
= G.7
= G.2
L.C. + P. Ave
Iron
488.37
948.86
29520
573.10
563.68
100.78
952.0
Hillcrest Golf Links

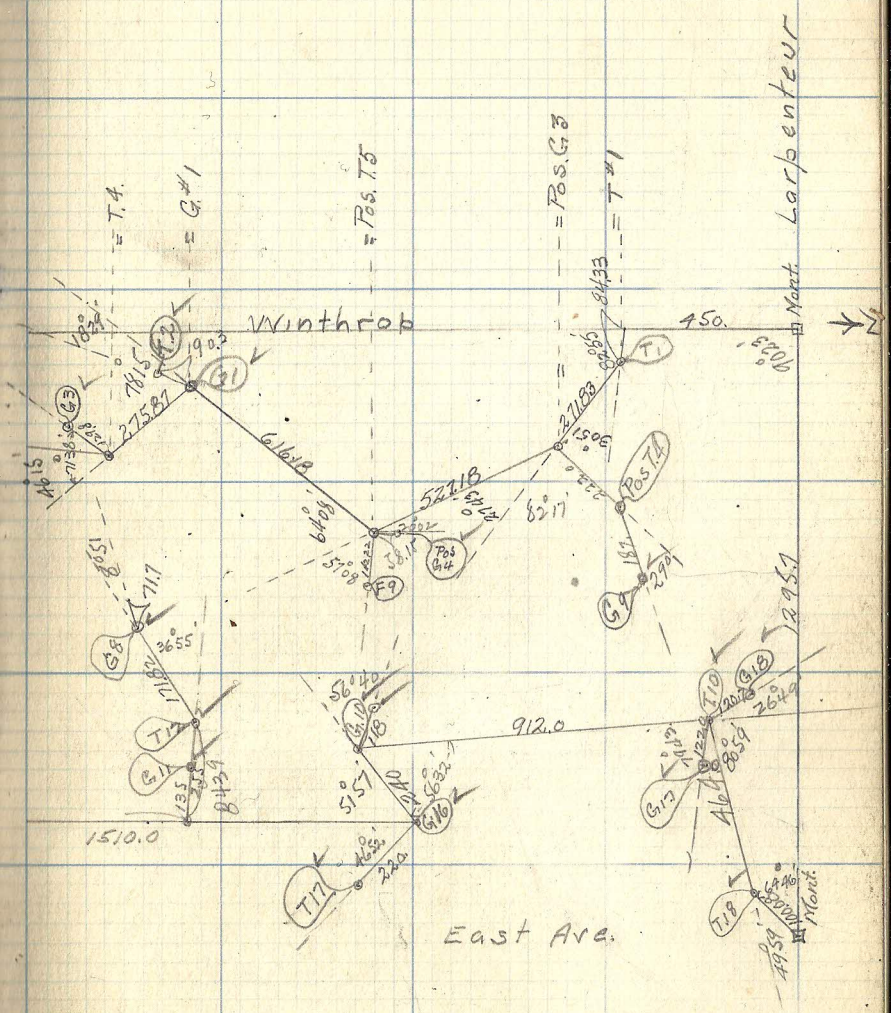
= T.4
= G.#1
= Pos. T.5
= Pos. G.3
= T.#1
Winthrop
Larpenteur
Mont.
450.
616.18
527.18
912.0
1510.0
East Ave.