

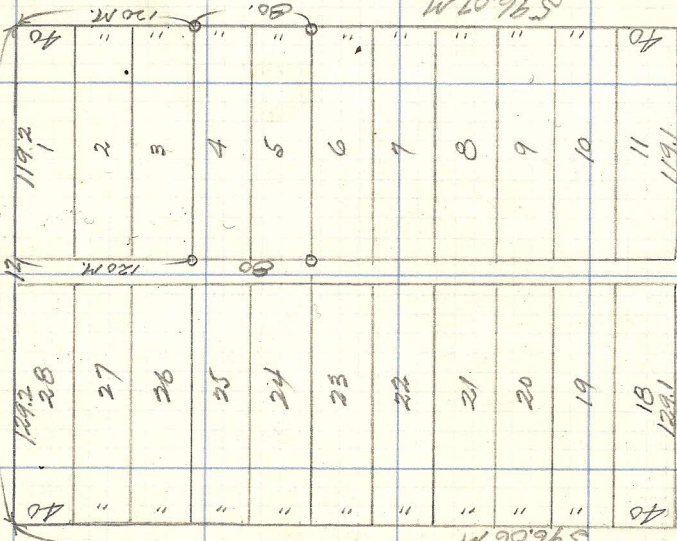


Ione 2604 R

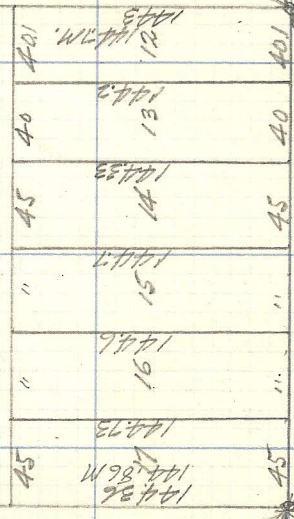

Malvern 596.86 M

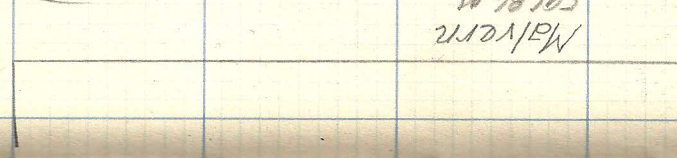

Larpentuer Ave

Lots 4+5

Staco Store.

66

10

