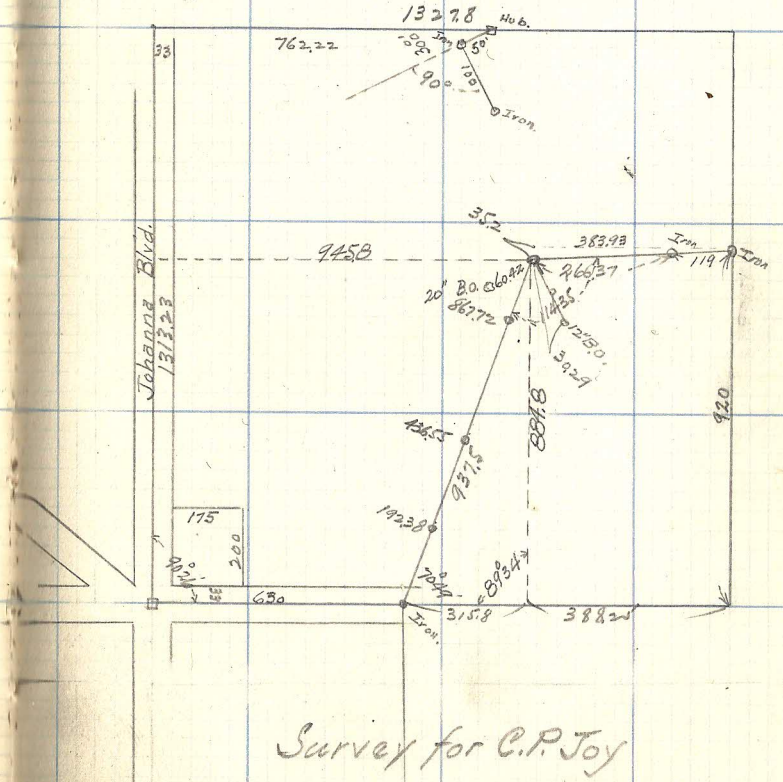

Survey for C.P. Joy

Gov. Lot 5 Sec. 33-30-23