

66
68


Frank
262.0 Rec.

66
48
TP.
32.88
39.32
Hvd
ER 461

Hathorne St.
593.75 Rec.

40	48.75	1	29	48.25
40	121	2	28	40
"	121	3	27	"
"	"	4	26	"
"	"	5	25	"
"	"	6	24	"
"	"	7	23	50.50 M.
"	50.50 M.	8	22	"
"	"	9	21	593.22 Rec.
"	"	10	20	"
40	11	19	19	40
20	121	121	121	20

St.
Maryland.
Lots B, K & Phalen Heights Park.

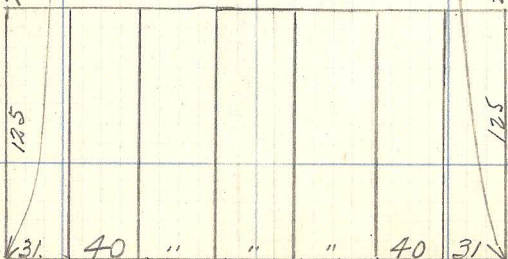

Earl St.
262.0 Rec.

60
30
42.44
42.44
Hvd