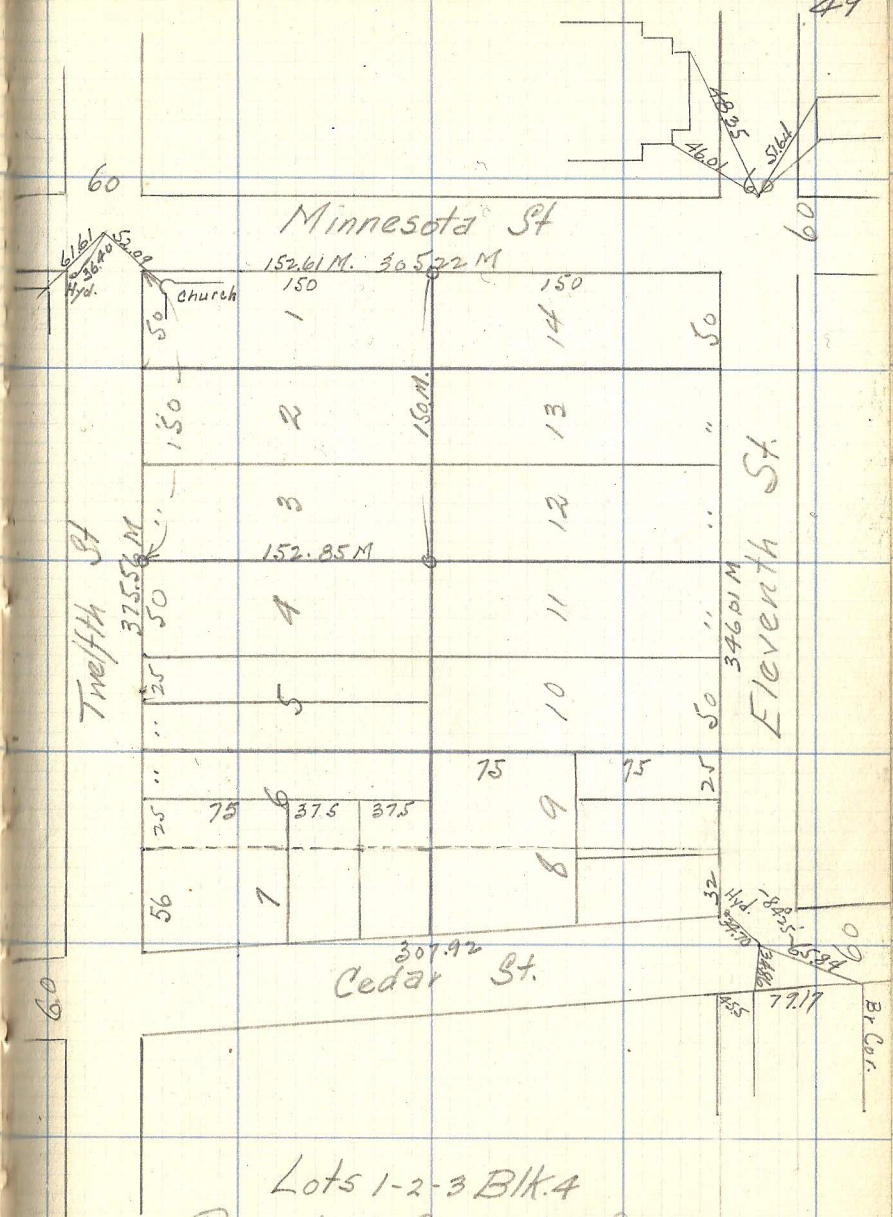
Minnesota St
Twelfth St
Eleventh St.
Cedar St.
Church
152.61 M.
305.22 M
152.85 M
150 M.
375.55 M
346.01 M
307.92
Br. Cor.
Lots 1-2-3 Blk. 4
Roberts & Randalls Add.