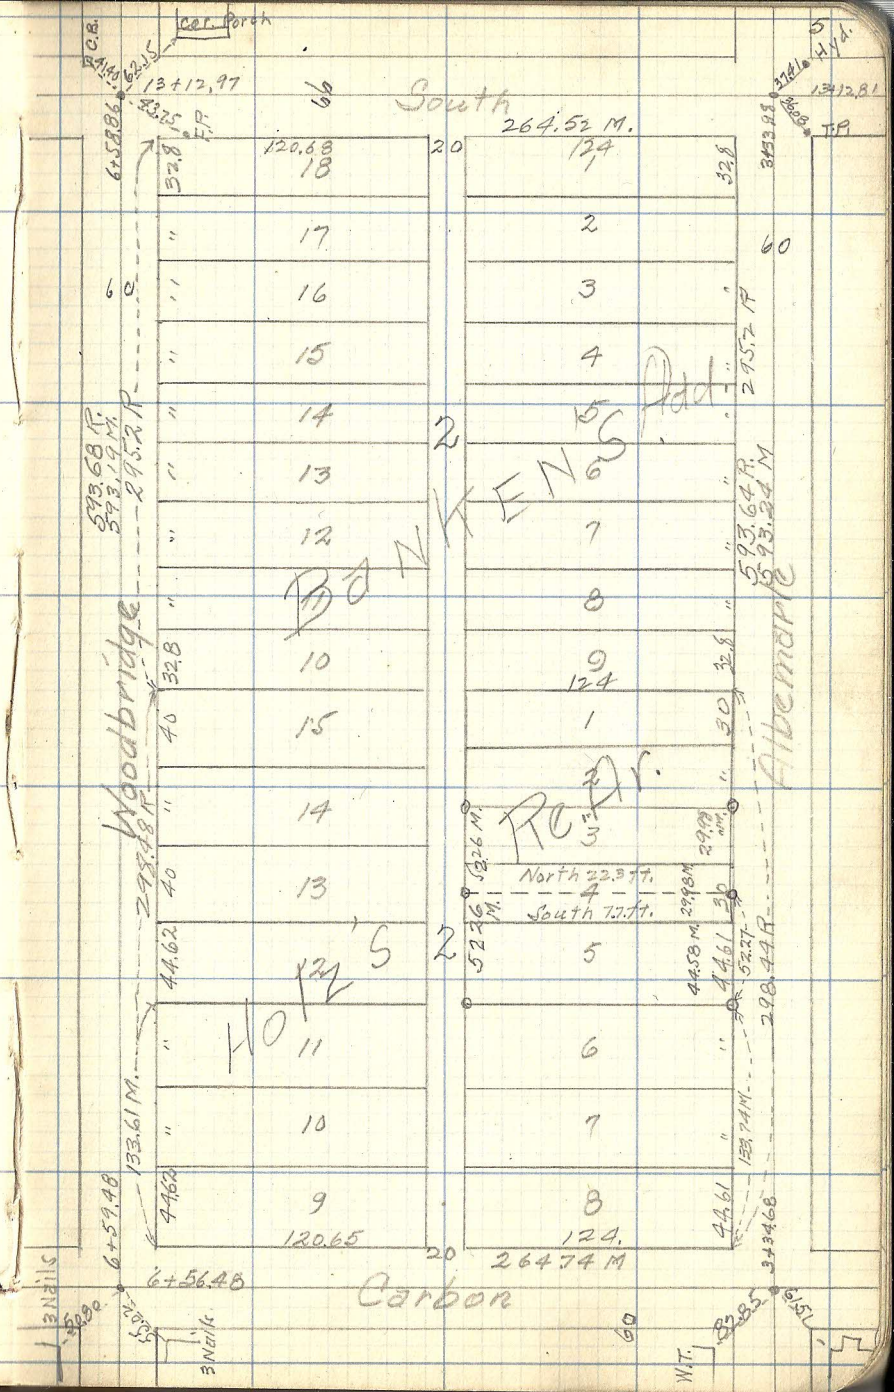

South
Carbon
Woodbridge
Albemarle
Hol's
Bankens Add.
Re Ar.
North 22.3 ft.
South 7.7 ft.
264.52 M.
264.74 M
120.68
120.65
124
124