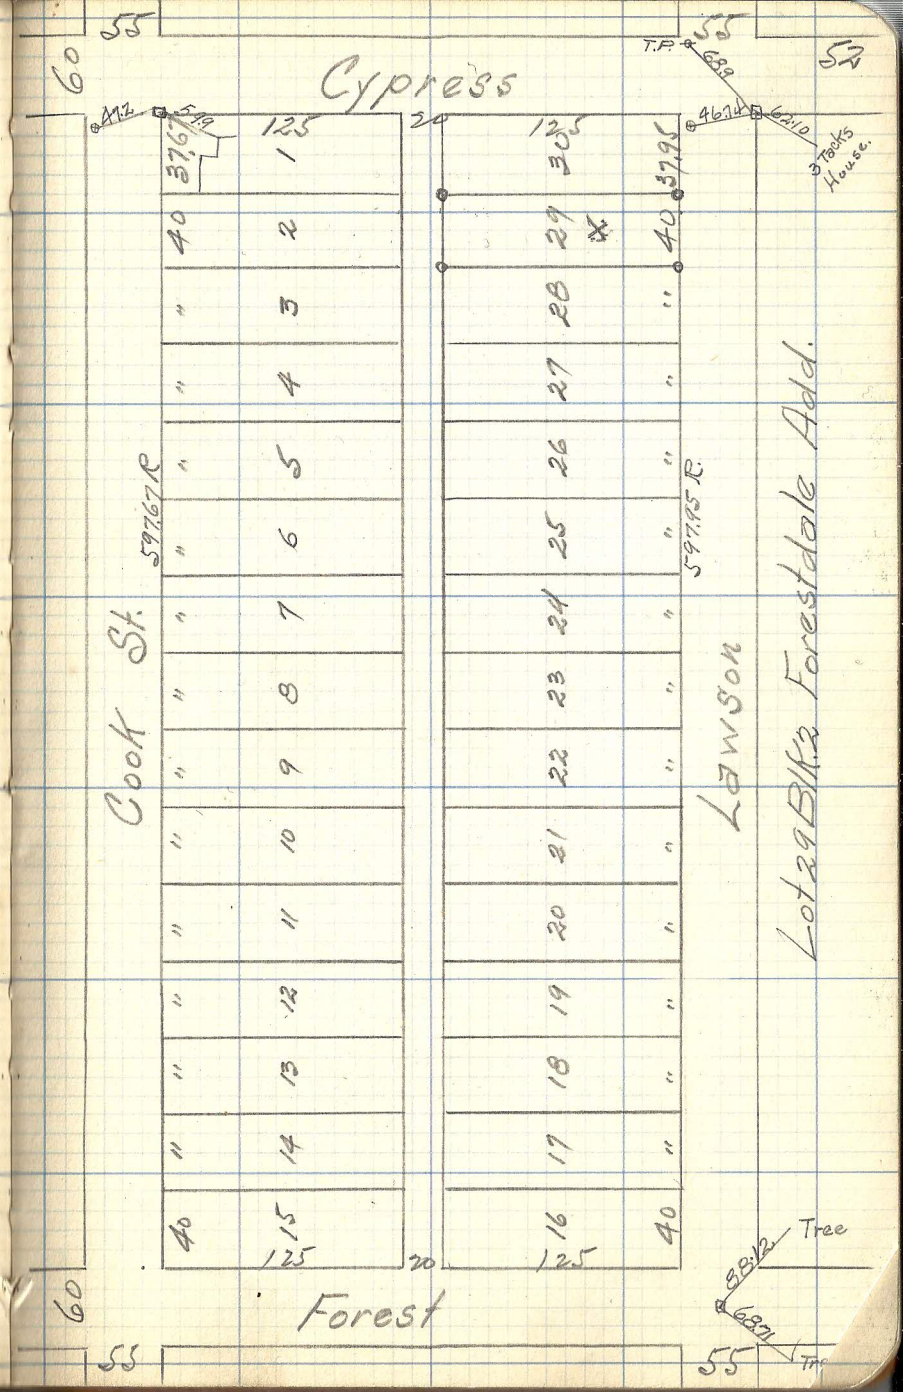
Cypress
Forest
Cook St.
Lawson
Lot 29 Blk 3 Forestdale Add.
55
60
125
20
40
T.P.
689
3 Tocks House
Tree
37.6
5.49
4.11
46.74
6.21.0
37.95
6.82
6.82½