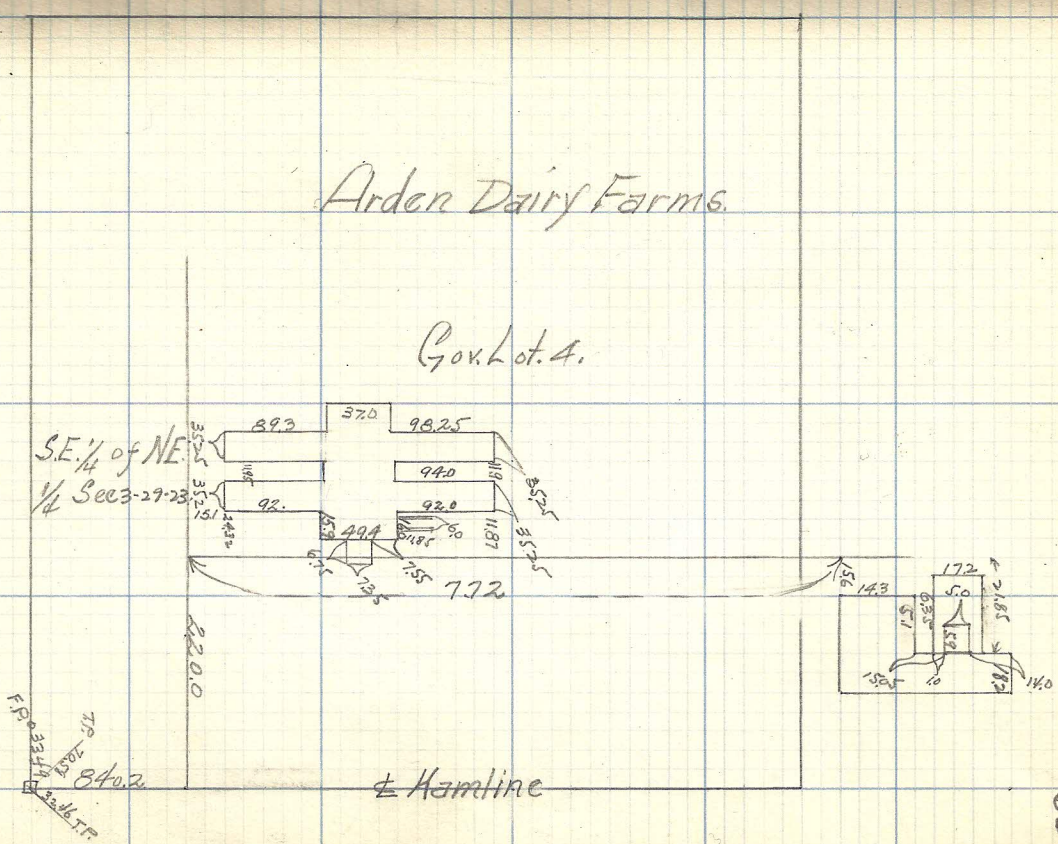
Arden Dairy Farms.
Gov. Lot. 4.
S.E. 1/4 of NE 1/4 Sec 3-29-23
89.3
37.0
98.25
94.0
92.
92.0
49.4
772
220.0
840.2
F.P. 3349
T.P. 70.5
32.46 T.P.
℄ Hamline
17.2
14.3
5.0
14.0