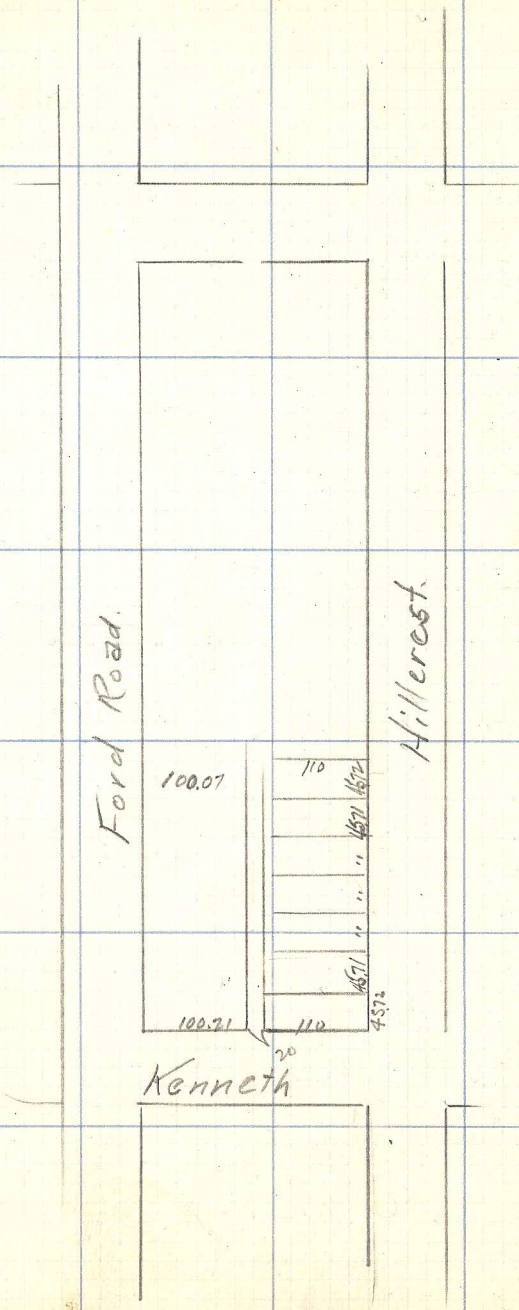

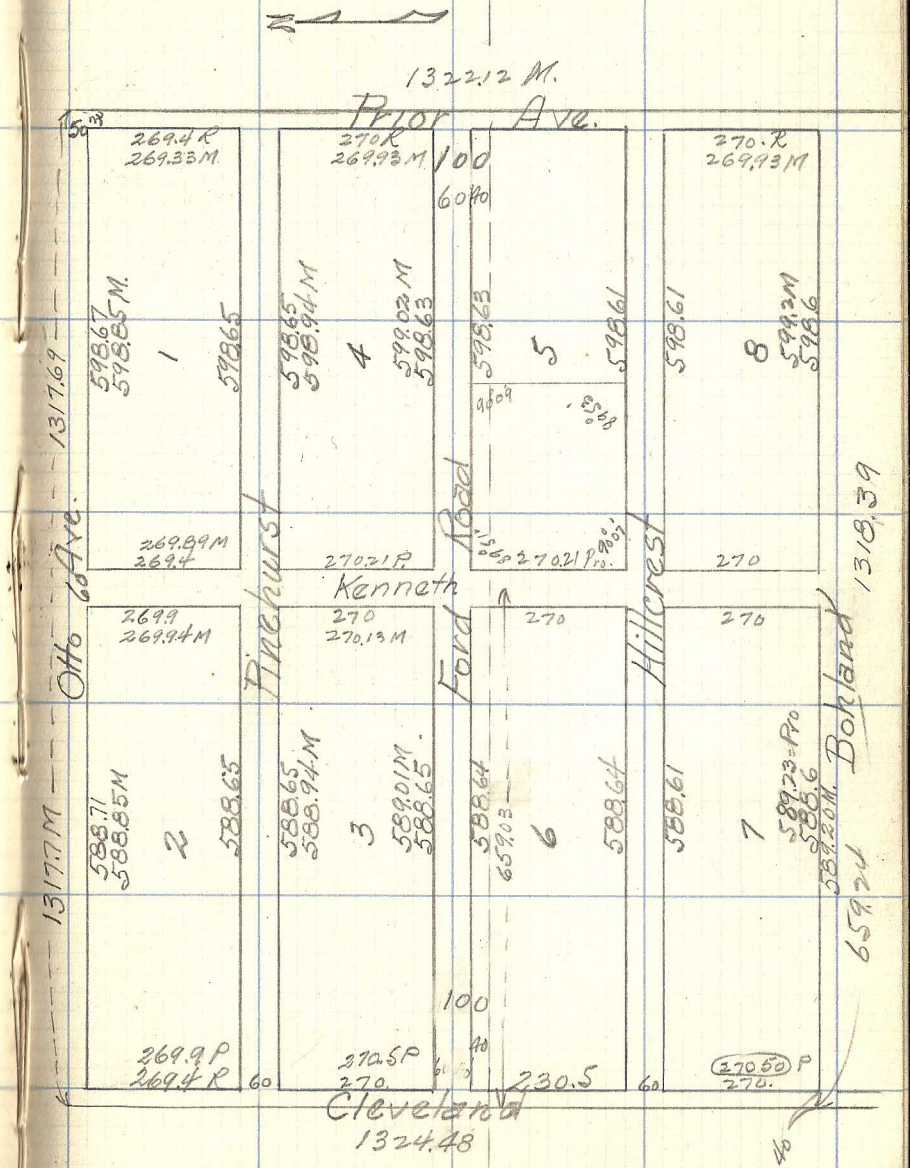

Otto To Bohland
Cleveland To Prior