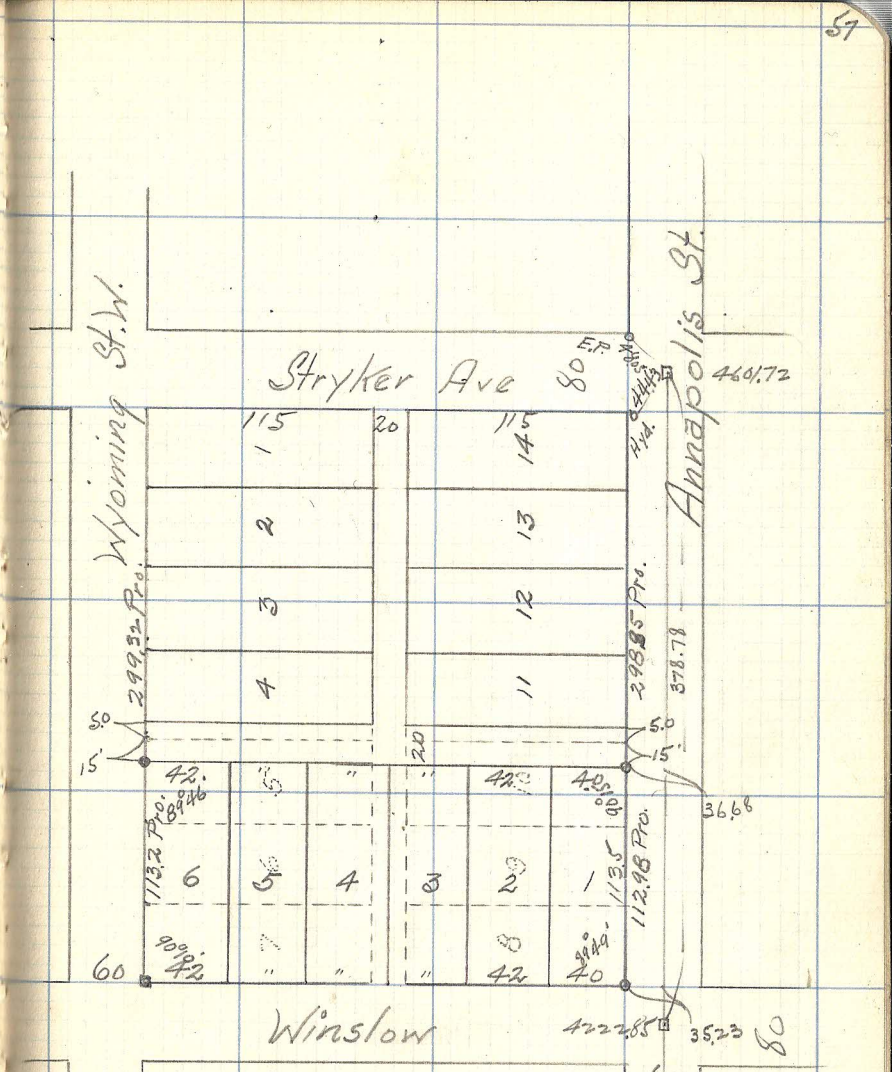

Mc Manigal & Varney's Re.
of Blk. 17 Jackson's & Bidwell's Add.

Re- of Lots 5-6-7-8-9-10
and W. 5 ft. of Lots 4 + 11