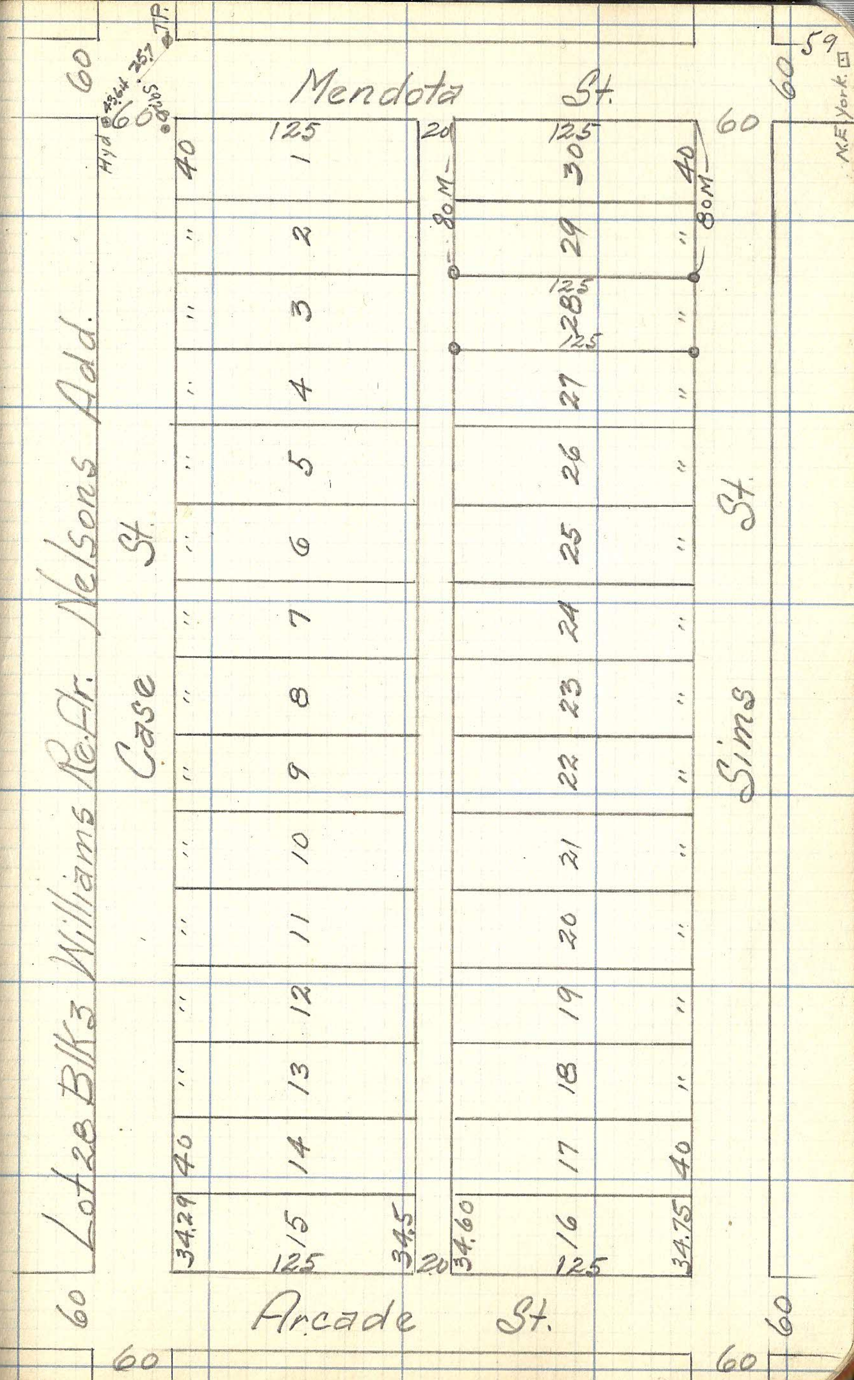
59
Lot 28 Blk 3 Williams Re. Ar. Nelsons Add.
Mendota St.
Arcade St.
Case St.
Sims St.
N.E. York
Hyd
T.P.
125
20
80 M
40
60
34.29
34.5
34.60
34.75
1
2
3
4
5
6
7
8
9
10
11
12
13
14
15
16
17
18
19
20
21
22
23
24
25
26
27
28
29
30