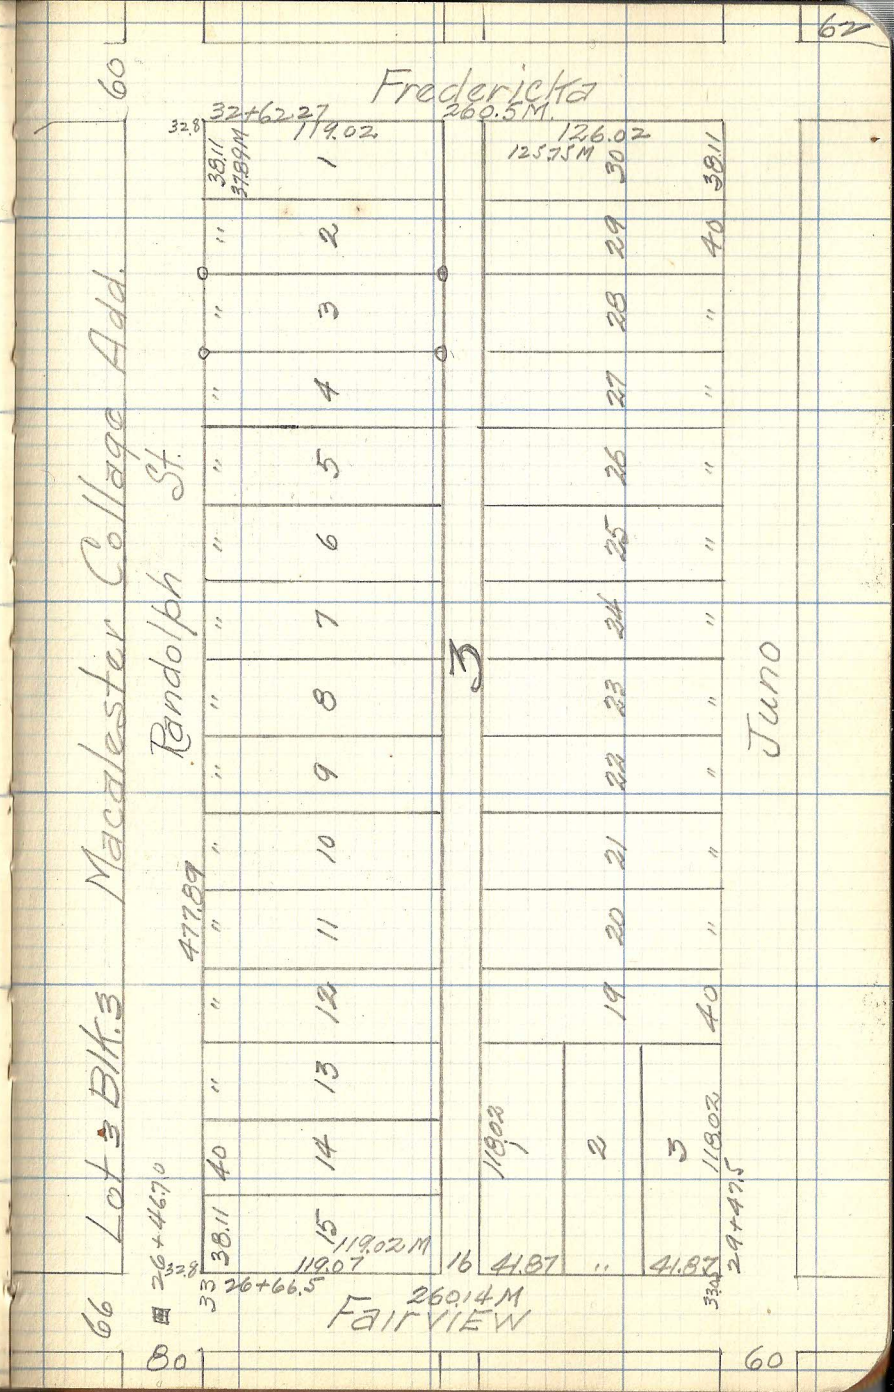
Fredericka
260.5M.
32+62.27
119.02
126.02
125.75M
38.11
37.99M
32.8
1
2
3
4
5
6
7
8
9
10
11
12
13
14
15
16
30
29
28
27
26
25
24
23
22
21
20
19
40
41.87
119.02M
119.07
119.02
119.03
26+46.70
26+66.5
29+47.5
260.14M
Fairview
Randolph St.
Macalester Collage Add.
Lot 3 Blk 3
Juno
66
80
60