



60
60

Winona
250.08M

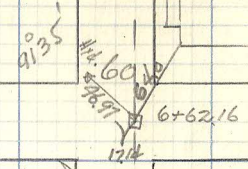


Chippewa

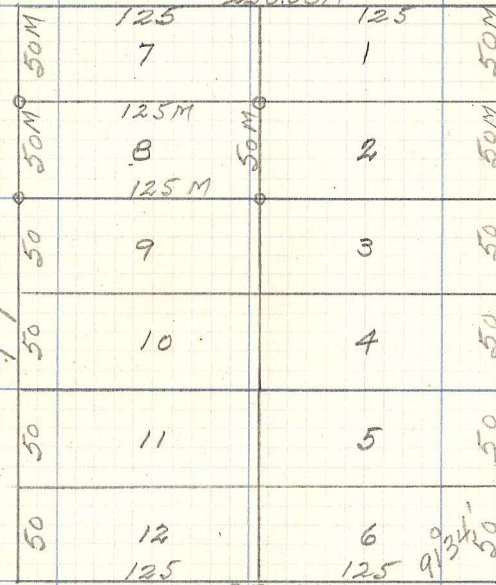

60
60

Wyoming

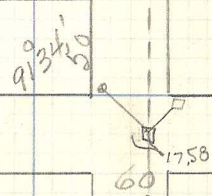

Lot 8 BLK 77
 Banning & Olivejer's
 Add.
 May 11-26