

60
60


Harvard St

266.4

S.E.

A

Browns & Jacksons Add.

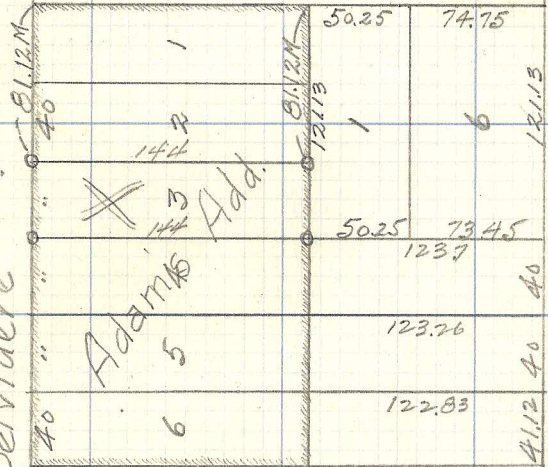

Belvidere

Adams Add.

LUCY STE

at Annapolis

161
141.42
2
121.86
3
102.3
Lot B.
57.7

Ockdale Ave.

Lots Adams Add.

121.13
123.7
123.26
122.83
124.3

50.25 74.75
50.25 73.45
123.7
123.26
122.83
124.3

40 40 40 40 40 40 40

108