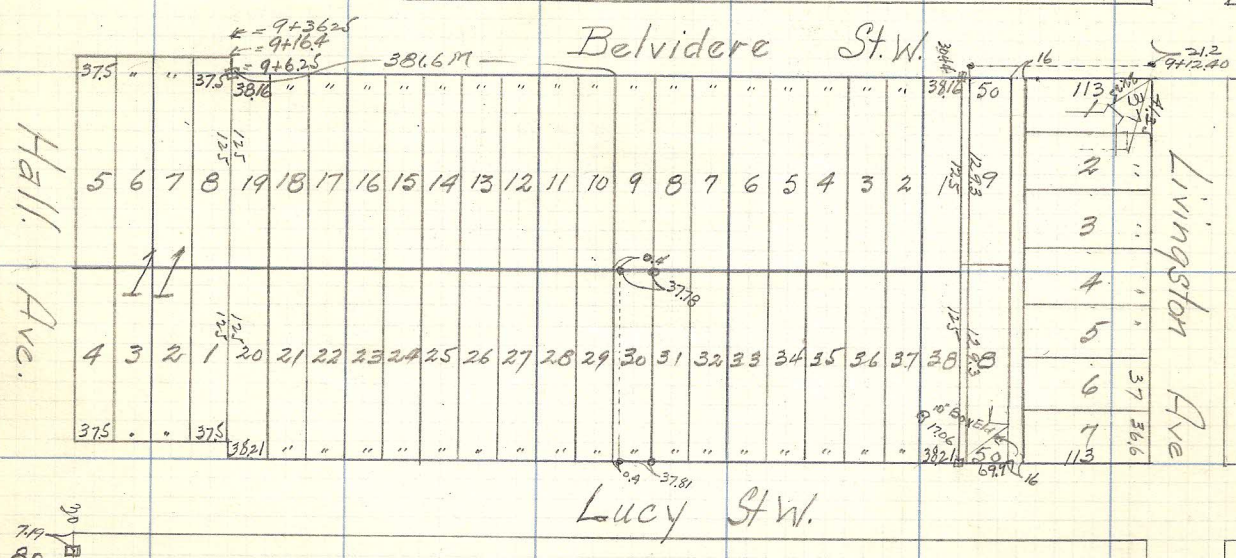

Corrected Plat of Auditors Sub.