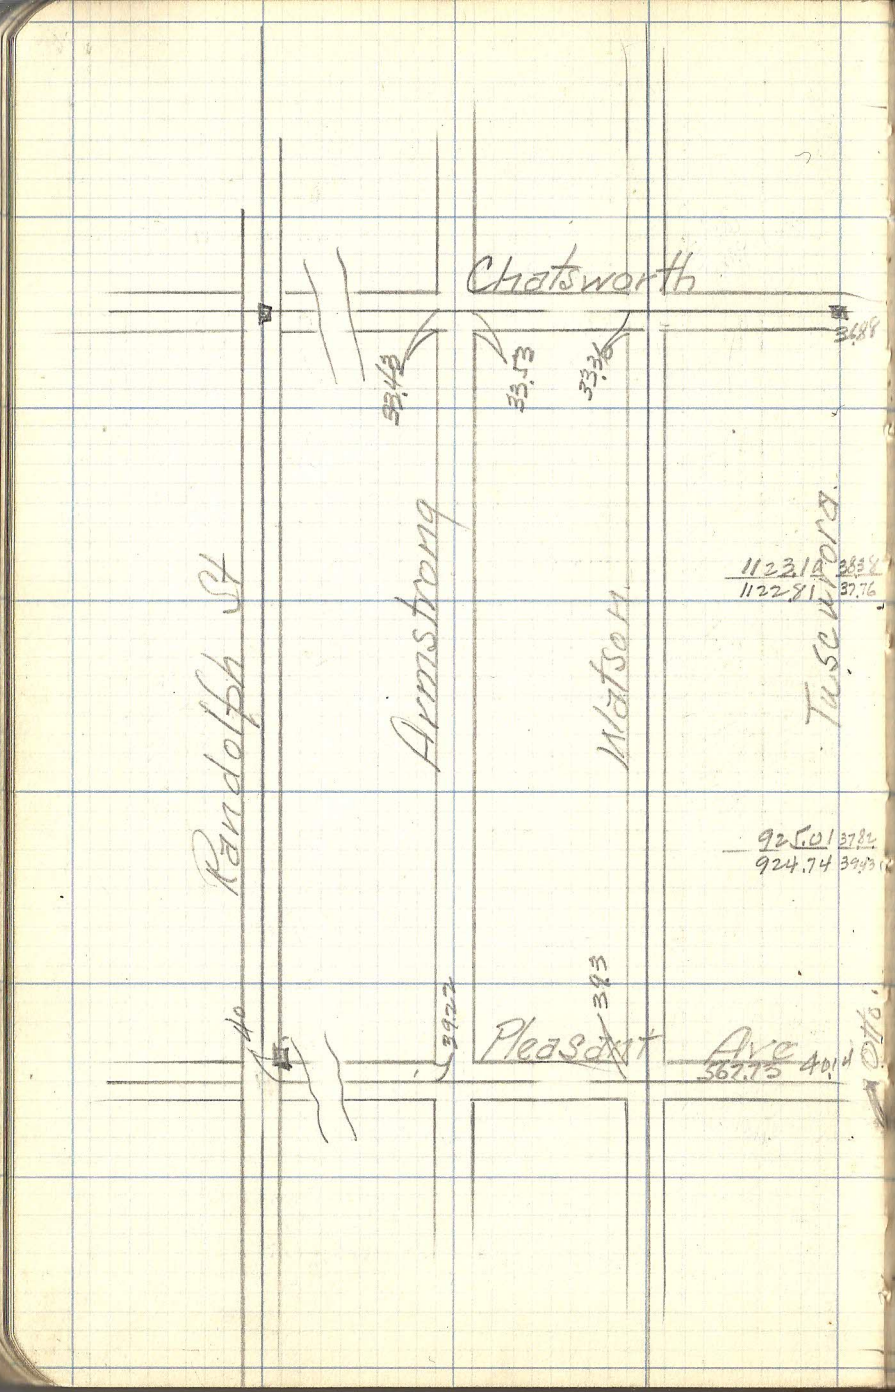
Chatsworth
Randolph St
Armstrong
Watson
Tuscarora
Pleasant Ave
Otto
33.73
33.36
112.19
112.81
37.76
925.01
924.74
567.5
401.4

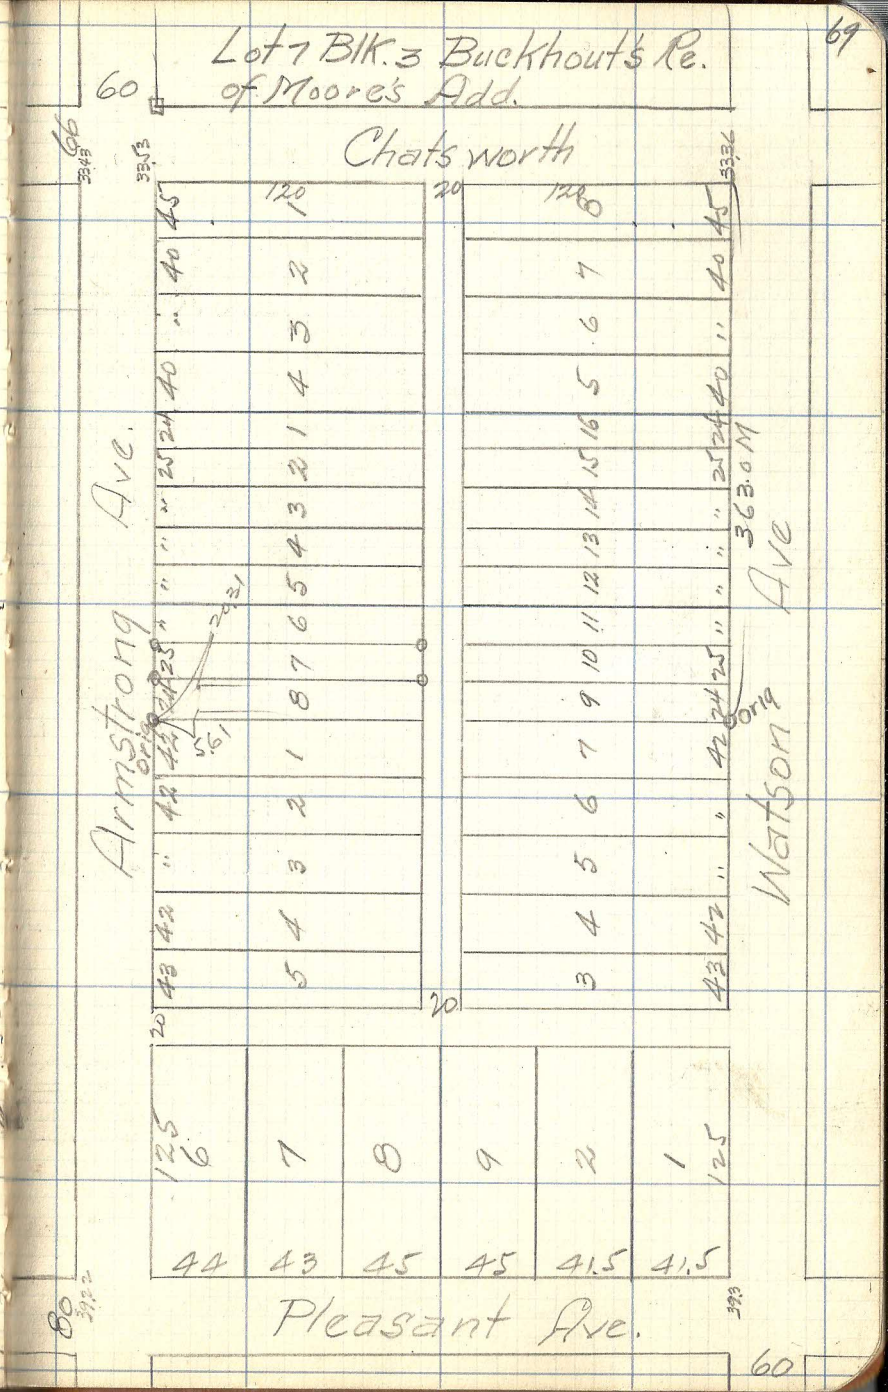
Lot 7 Blk. 3 Buckhout's Re. of Moore's Add.
Chatsworth
Armstrong Ave.
Watson Ave
Pleasant Ave.
363.0M
561
44
43
45
45
41.5
41.5