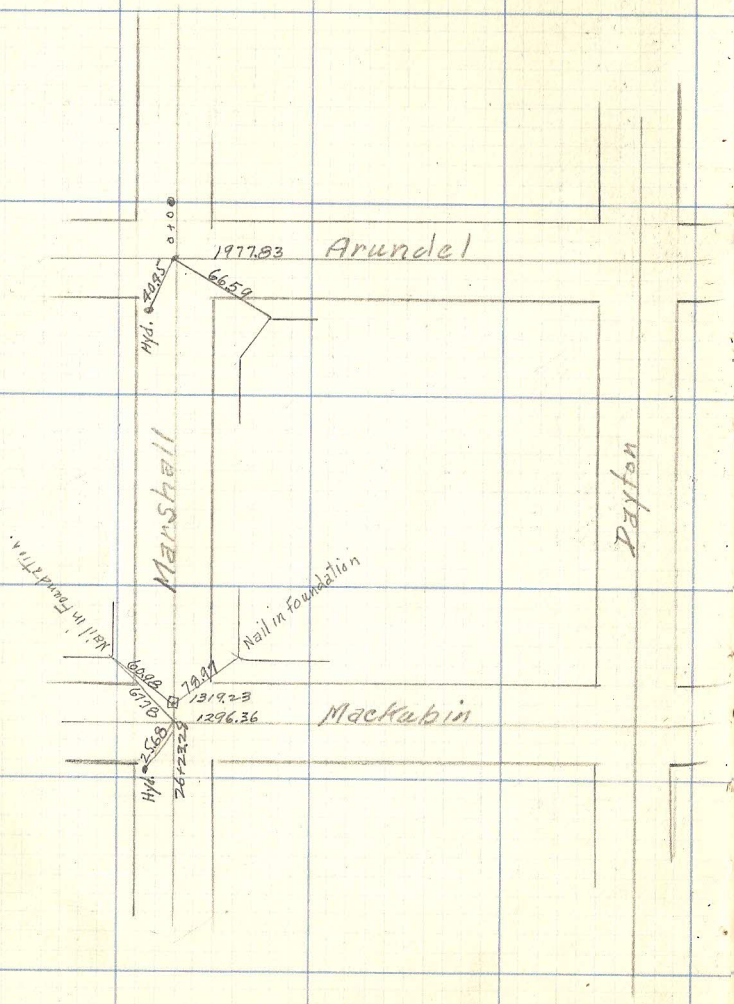

Arundel
1977.83
66.59
Hyd. 40.95
Marshall
Dayton
Nail in Foundation
Nail in Foundation
60.08
67.78
78.97
1319.23
1296.36
Mackubin
25.68
Hyd.
26+23.25

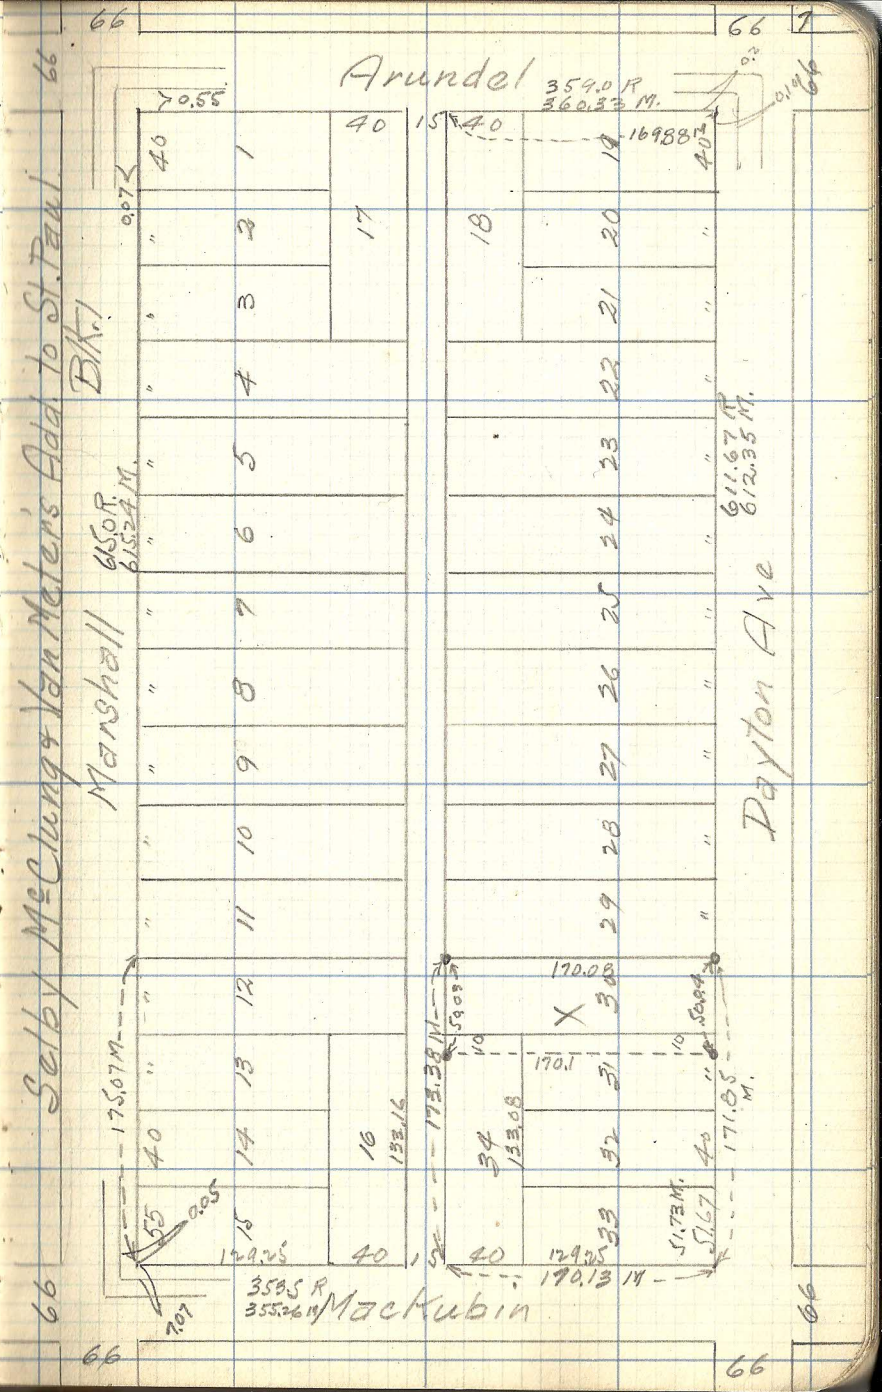

Selby McClung & Van Meter's Add. to St. Paul
Arundel
359.0 R
360.33 M.
169.88 M.
Marshall
615.0 R.
615.24 M.
Dayton Ave
611.67 R
612.35 M.
170.08
170.1
175.07 M.
173.38 M.
171.85 M.
133.16
133.08
129.25
170.13 M
353.5 R
355.26 M
Mackubin