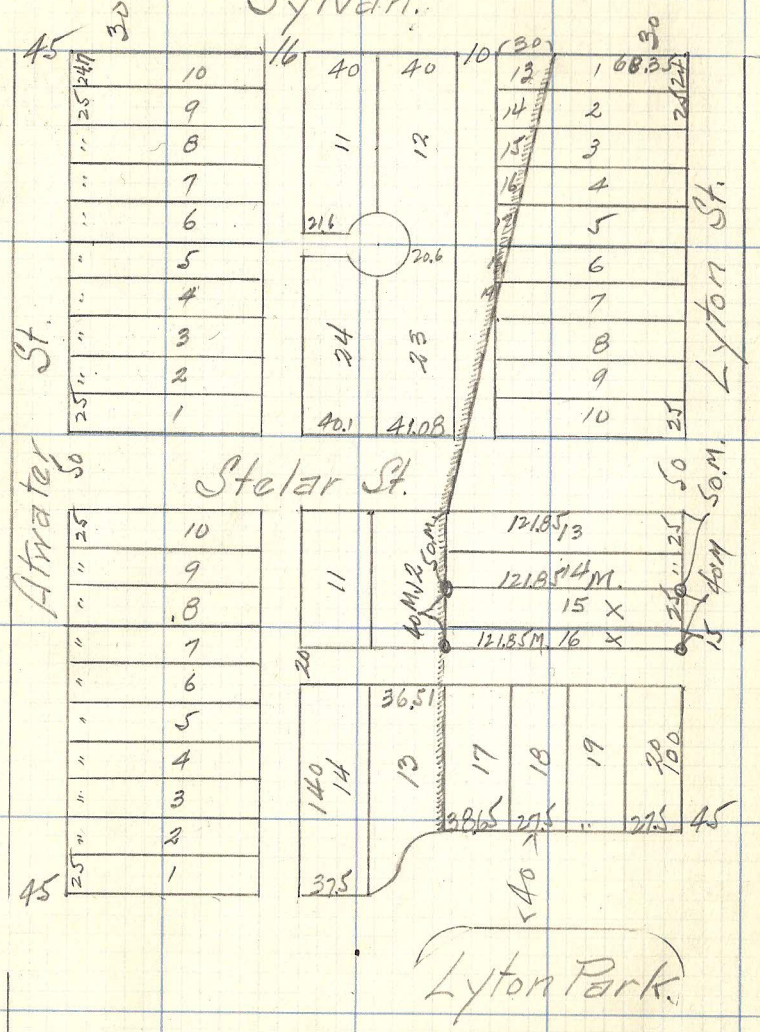

Also in Book 3, page 6

Lot 15+16 Blk 1
Lytons Add.