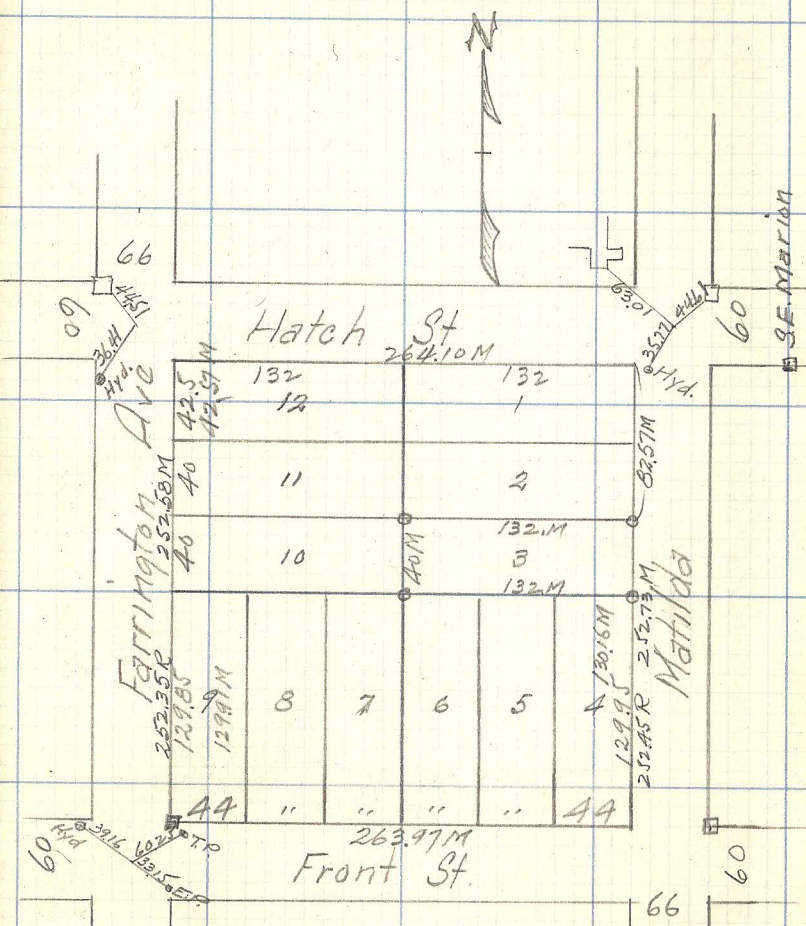

Lot 3 Blk 48
Auerbach & Hands Add.