Lots 20-21-22-23 Blk 2
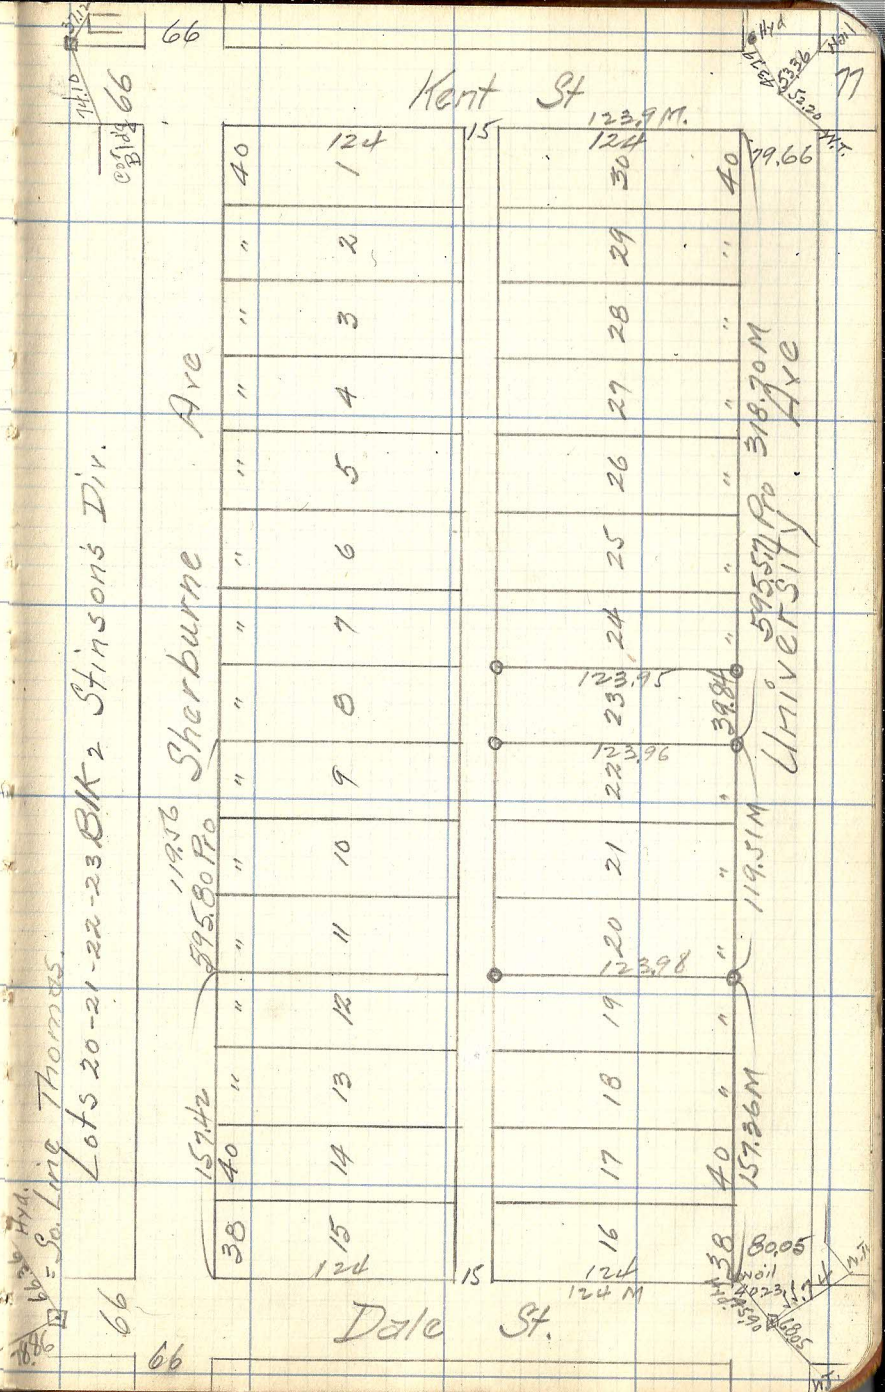
Stinson's Div.