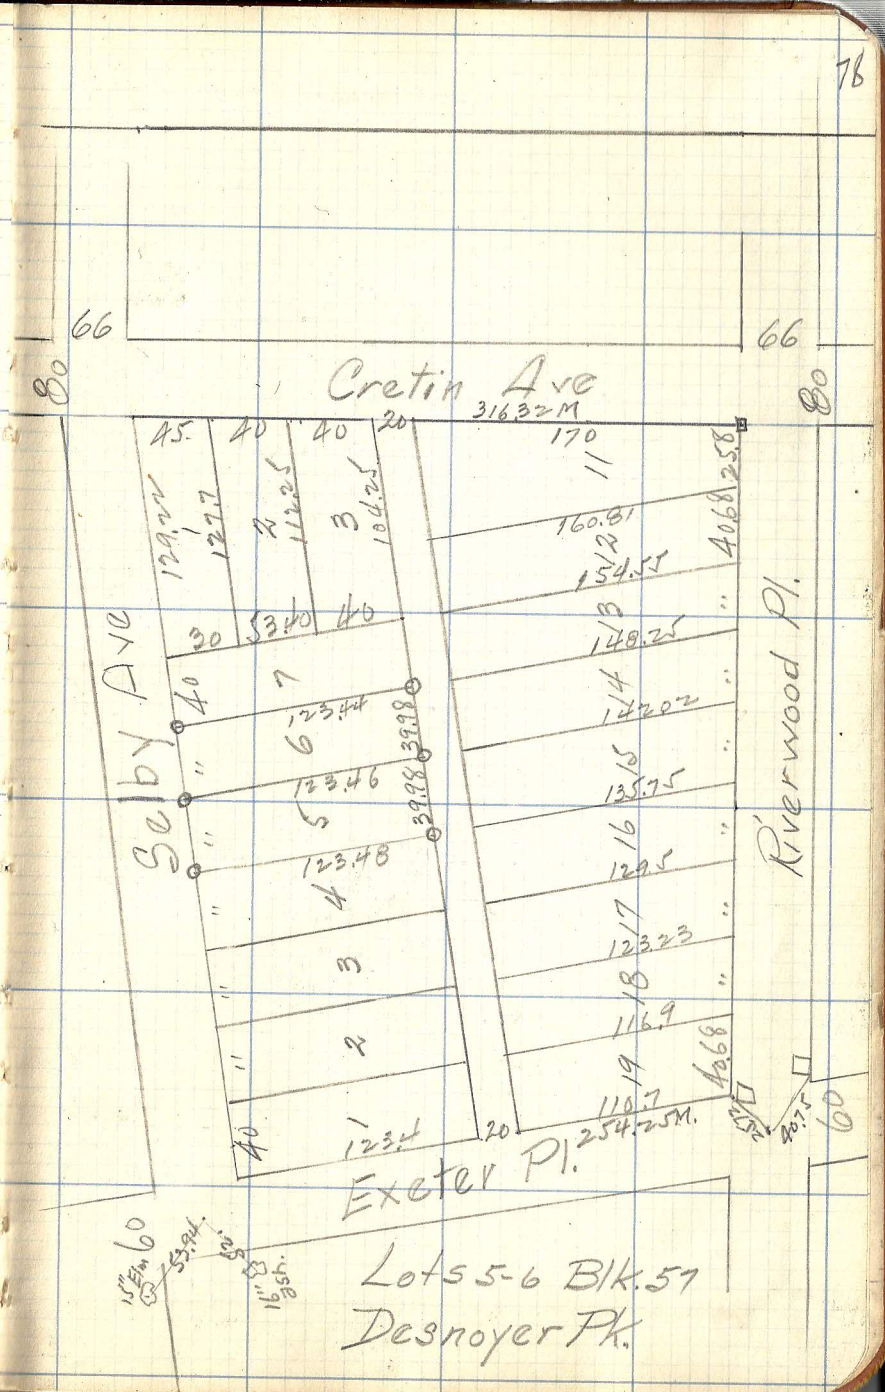
66
66
80
80
Cretin Ave
316.32M
170
45.
40
40
20
129.22
127.7
112.25
104.25
160.81
154.51
148.25
147.02
135.75
129.5
123.23
116.9
110.7
42.68
40.75
254.25M.
30
53.40
40
40
123.44
123.46
123.48
123.44
39.98
39.98
Selby Ave
Riverwood Pl.
Exeter Pl.
60
60
15" Elm
55.9ft.
16" Ash
Lots 5-6 Blk. 57
Desnoyer Pk.