
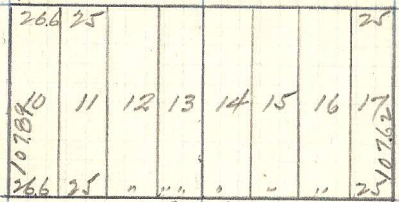
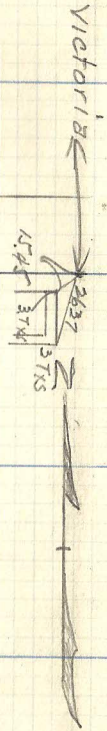


50

Hatch St

50

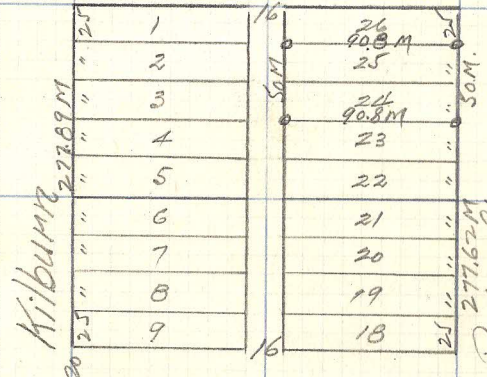

66

201.6 M  
Front St.

Lots 24-25 BIK. 54  
Denstons Sub.