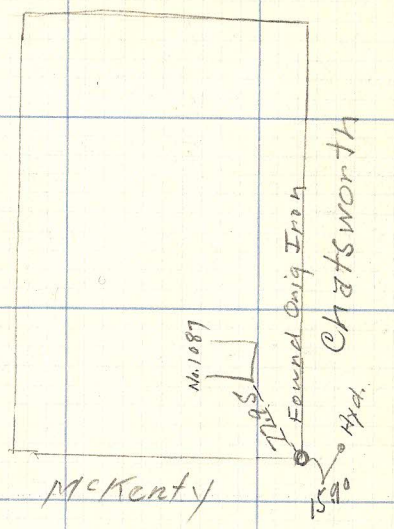
No. 1687
Found Orig. Iron
Hyd.
Chatsworth
McKenty

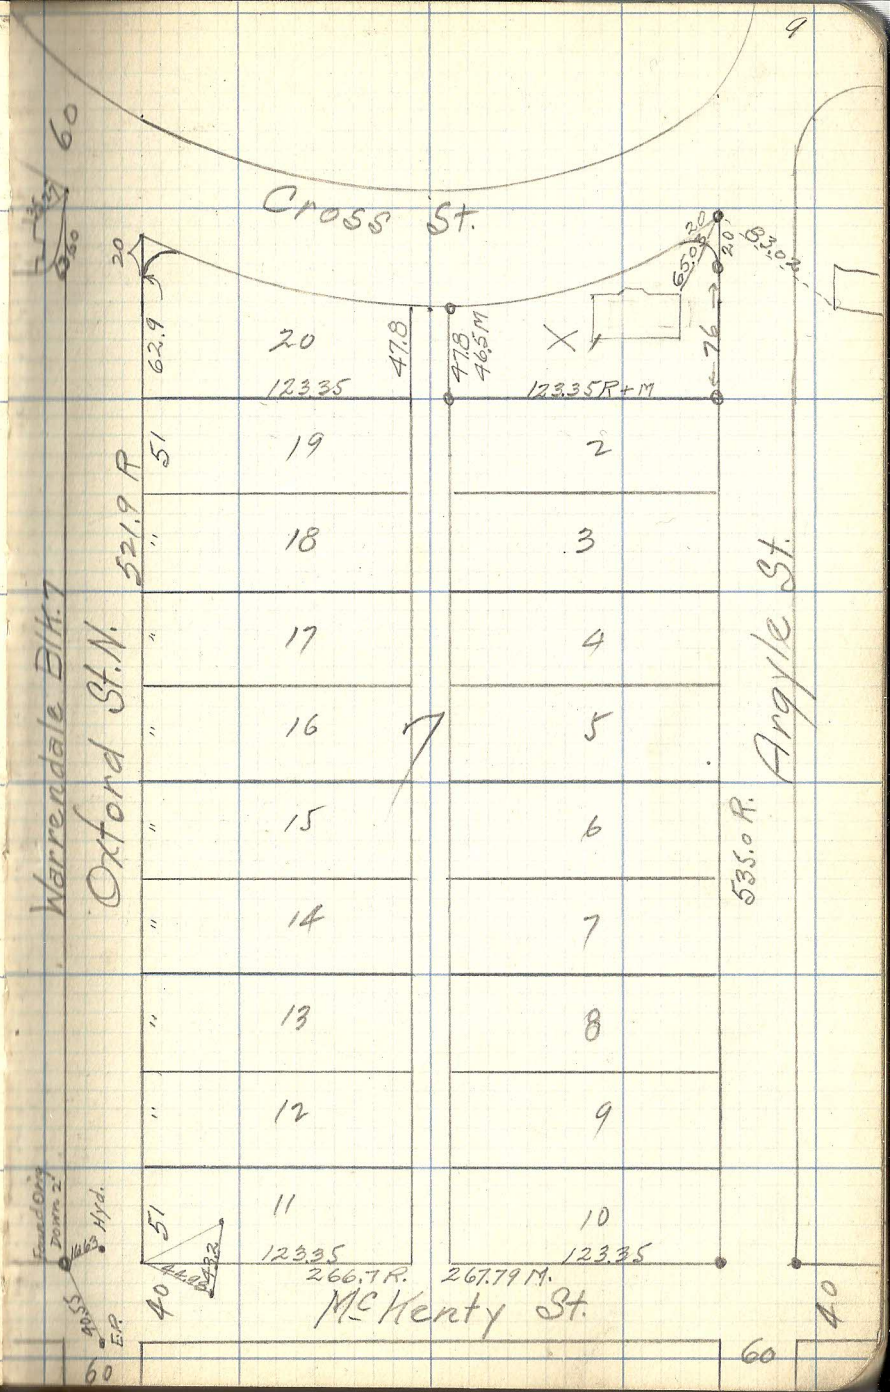
Cross St.
60
20
62.9
20
123.35
47.8
47.8
46.5 M
123.35 R+M
65.0
20
20
83.0
76
51
19
18
17
16
15
14
13
12
11
2
3
4
5
6
7
8
9
10
521.9 R
Warrendale Blk. 7
Oxford St. N.
Argyle St.
535.0 R.
51
123.35
123.35
266.7 R.
267.79 M.
Found Orig. Pcm. 2"
Hyd.
40.55
E.P.
40
McKenty St.
60
60
40