


66
29.7
29.4


66

Carroll Ave

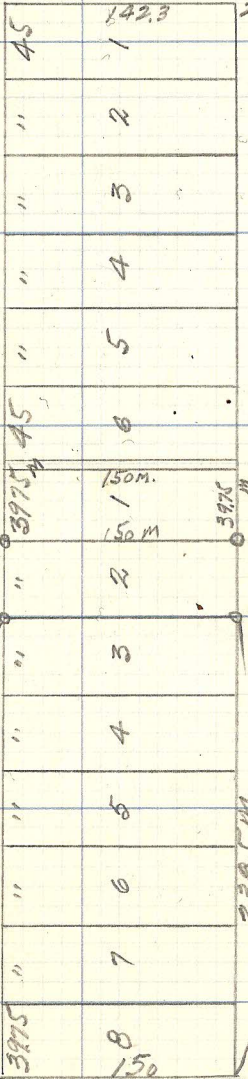

Fairview Ave

Wheeler Ave

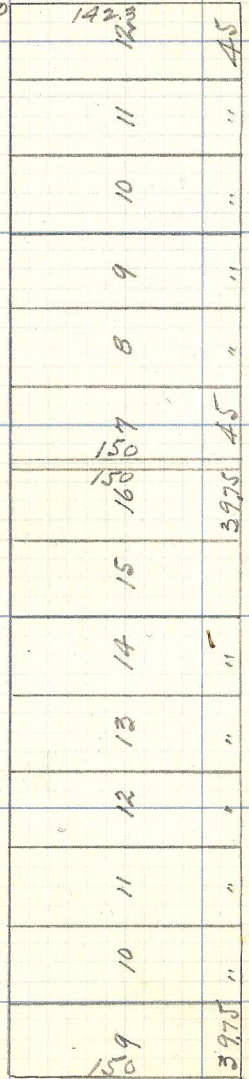

29.2
29.8

66

Iglehart Ave

Lots B1K8 Loving Park