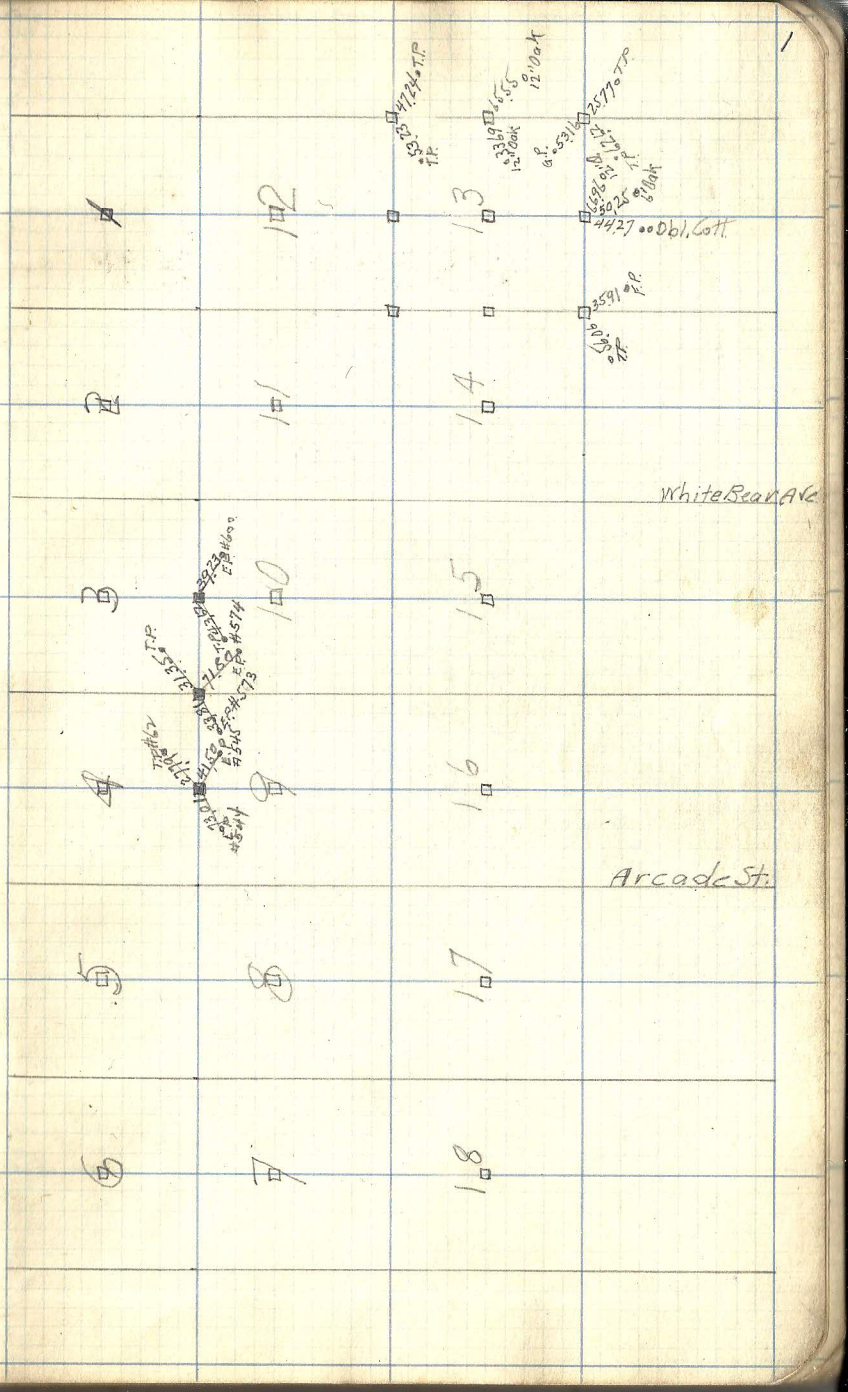Index in Back of Book.