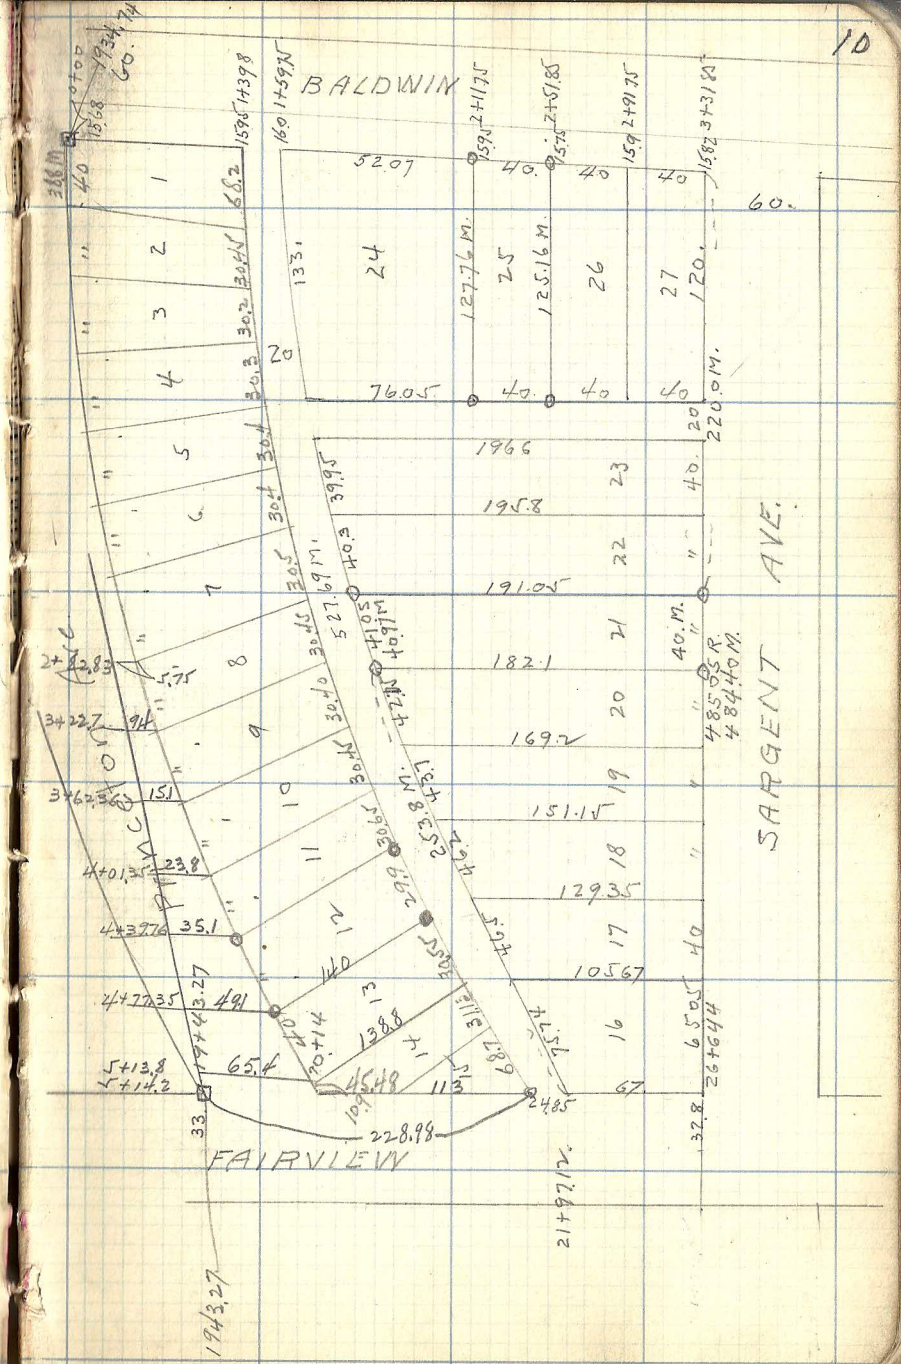WRIGHT & WILLIAM'S RE.
Lot 1 & 25 BLK. 1