East ½ of Lot 9 Blk 10
Elfelt. Bernheimer & Arnolds Add.
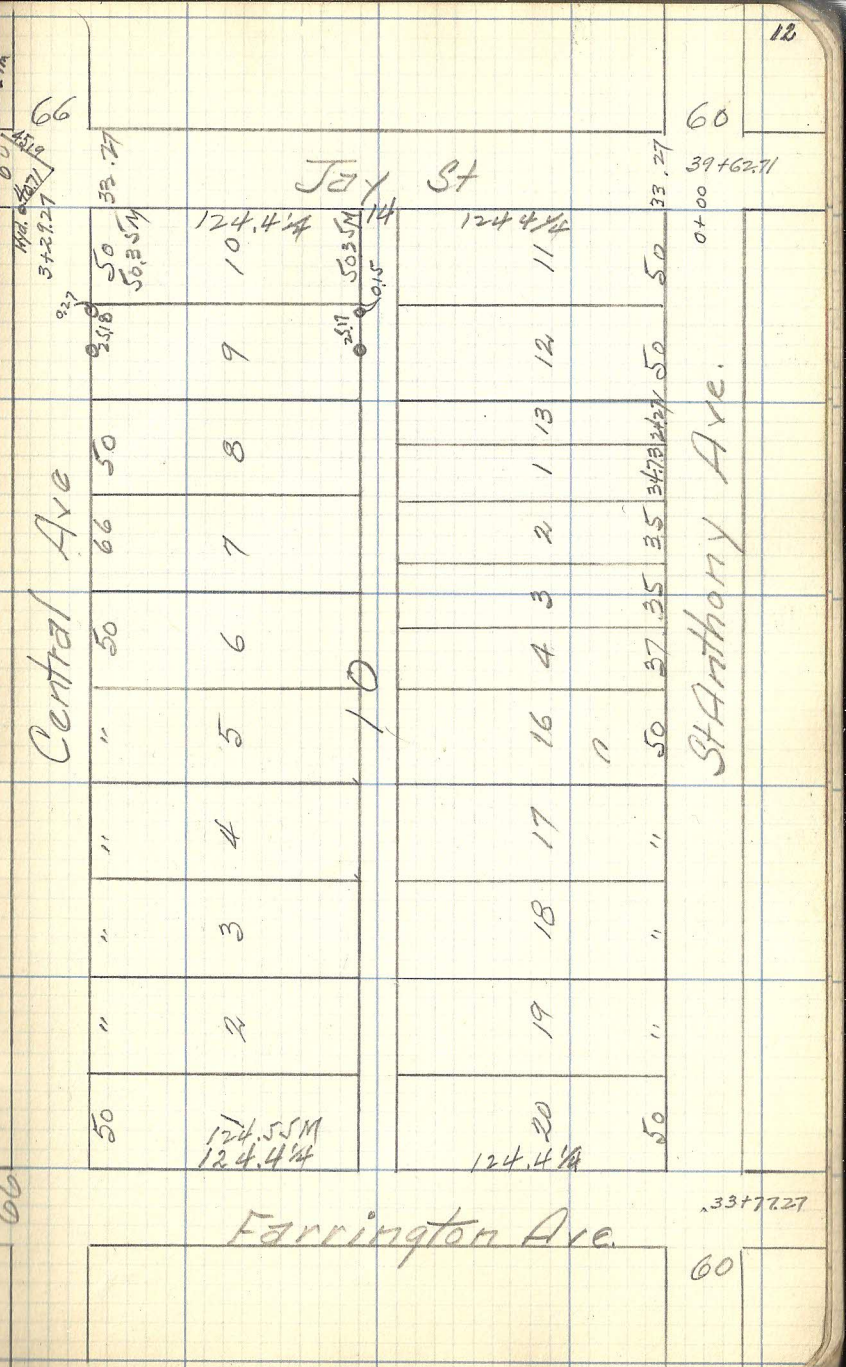
Location of Eaves & Gutter
on page 22