Jan. 8-1924
R.H.

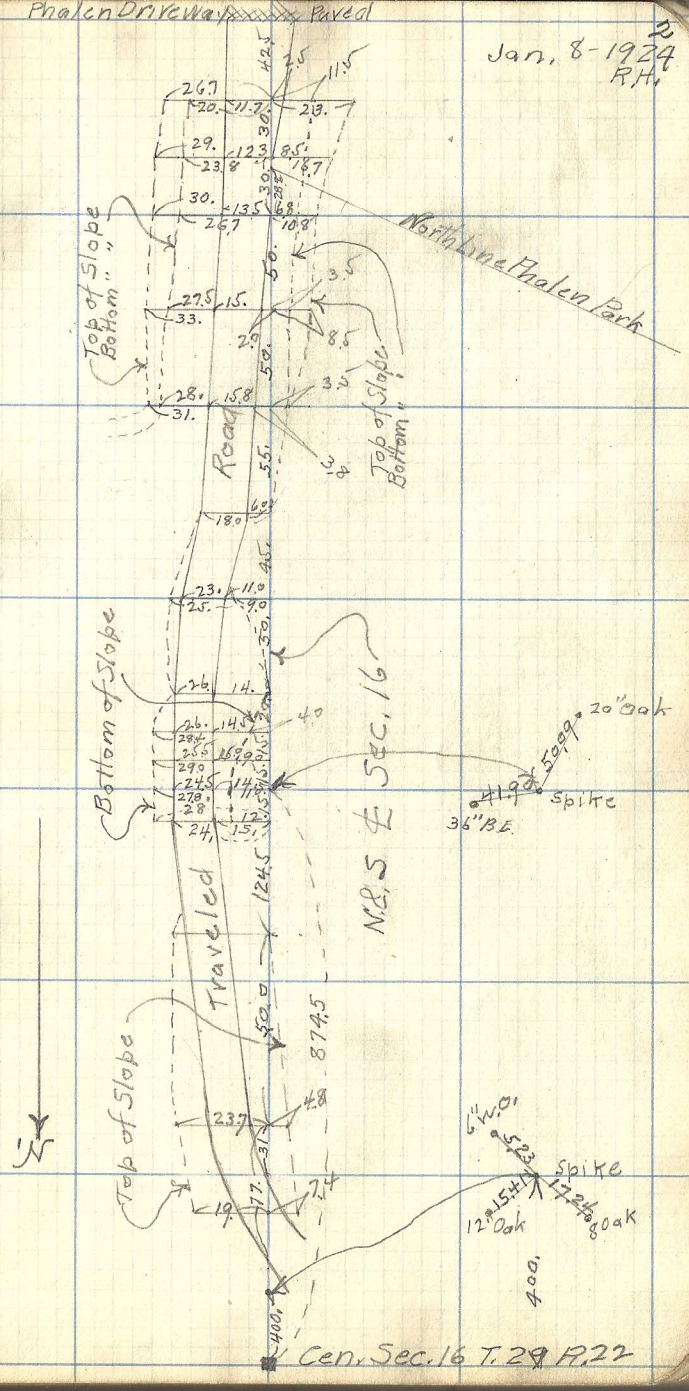
Phalen Driveway
Paved
North Line Phalen Park
Top of Slope
Bottom
Road
Top of Slope
Bottom
Bottom of Slope
N.E. ¼ Sec. 16
Traveled
Top of Slope
874.5
400.
400.
N
20" Oak
Spike
36" B.E.
6" W.O.
Spike
12" Oak
8 Oak
Cen. Sec. 16 T. 29 R. 22