Location of Buildings

East 3673 ft Warren & Rice's Add.
↑
Lot 9
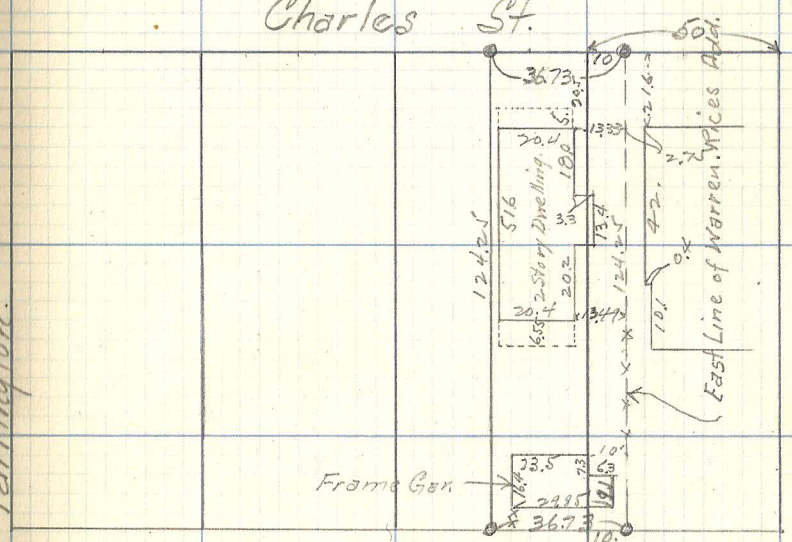
Charles St.