


Lot 6+7 BIK. 34.
St Anthony Park.

50	"	"	"	"	50	457
9	10	11	12	13	14	15
66	50	"	"	"	50	489

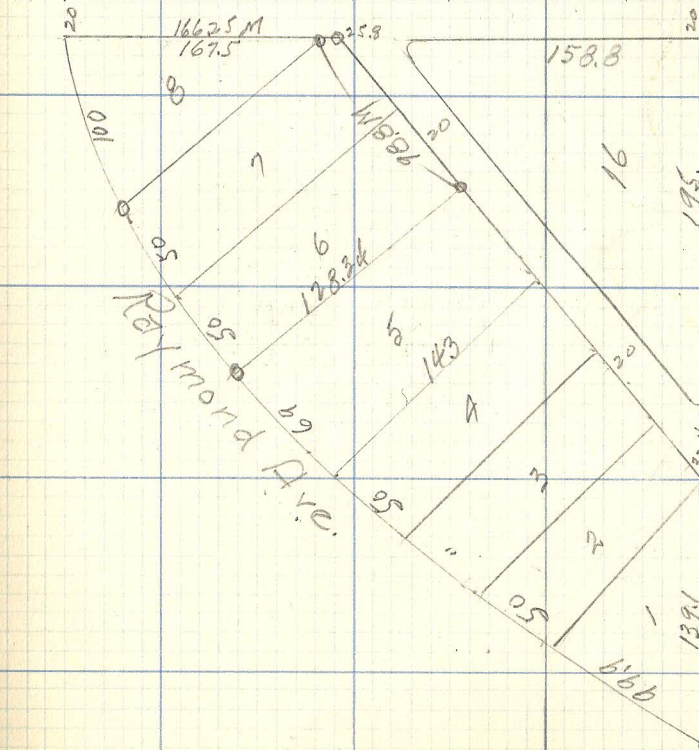

L.G.N. P.W.